


**T. 22 S. R. 3 W. W. M.**

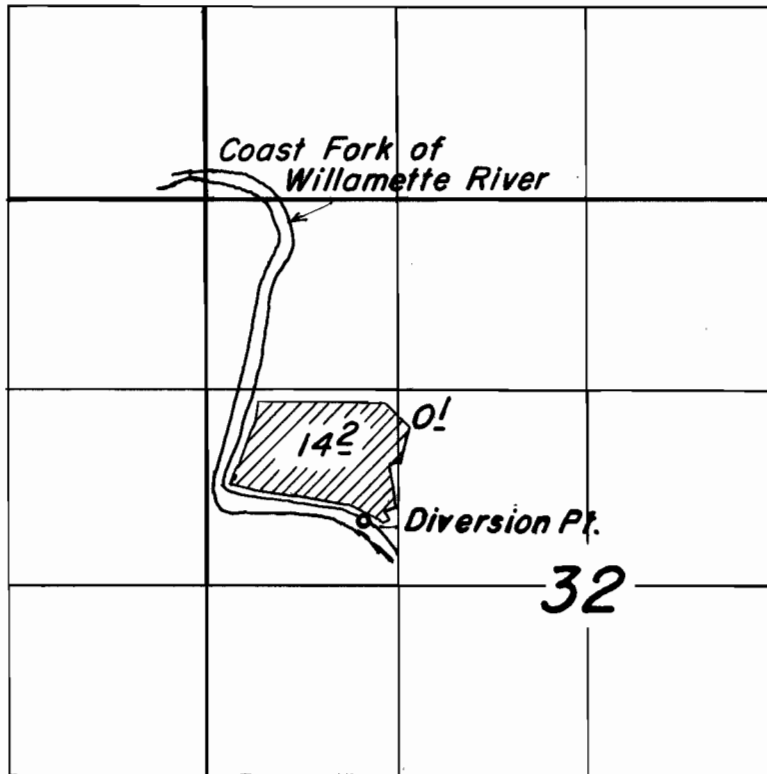

**FINAL PROOF SURVEY**  
UNDER

Application No. 33050 Permit No. 26141  
IN NAME OF

Nelson Bemis

Surveyed June 21 1963, by C. Baker