


T.11S., R.9W., W.M.

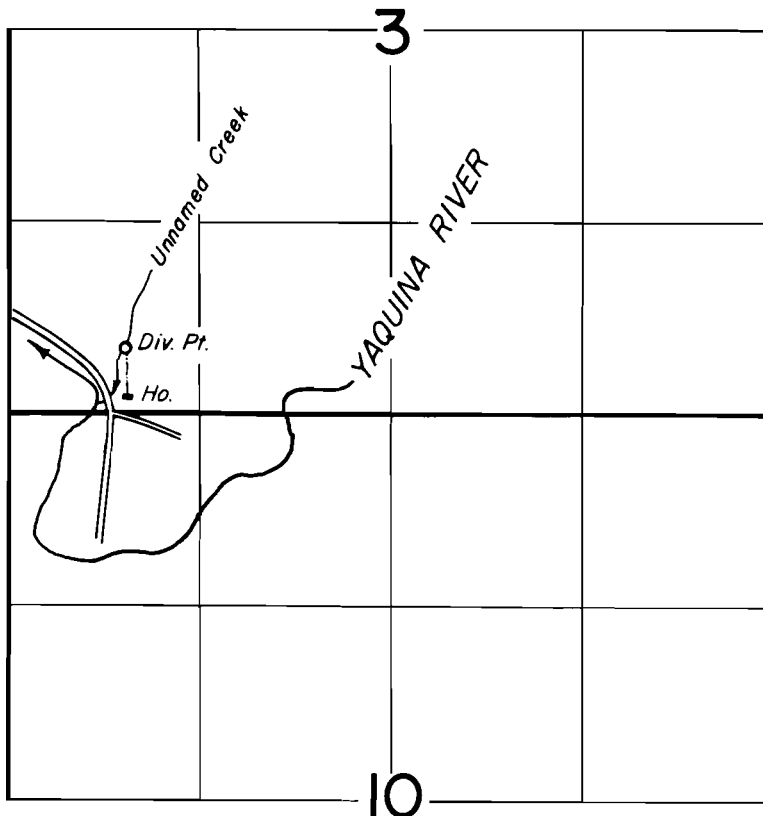

DIV. PT. LOC.: 450' N, & 800' E, from the SW Corner Section 3

FINAL PROOF SURVEY
UNDER

Application No. 58820 Permit No. 44299
IN NAME OF

Delmar E. Pilson

Surveyed Sept. 26, 1979, by J. L. Brown