


T.8S. R.6W., W.M.

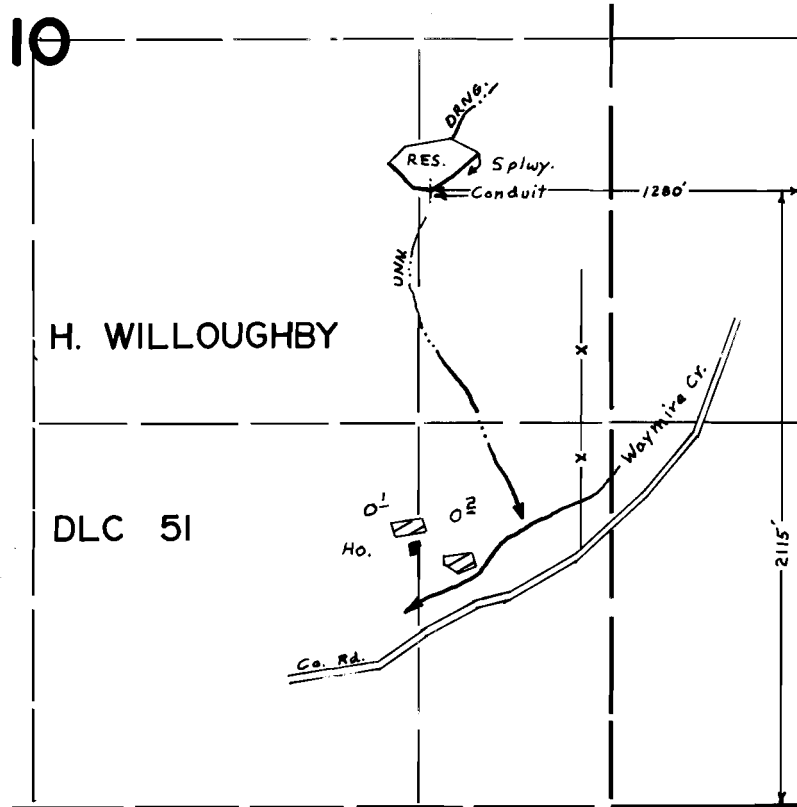

Scale: 1" = 660

FINAL PROOF SURVEY UNDER

R-50974 R-6199
Application No. 50975 Permit No. 38476
IN NAME OF

RICHARD HARUSTAK

Surveyed MAR. 14. 1978. by J.S. DONALDSON