




T.2S.,R.32E.,W.M.

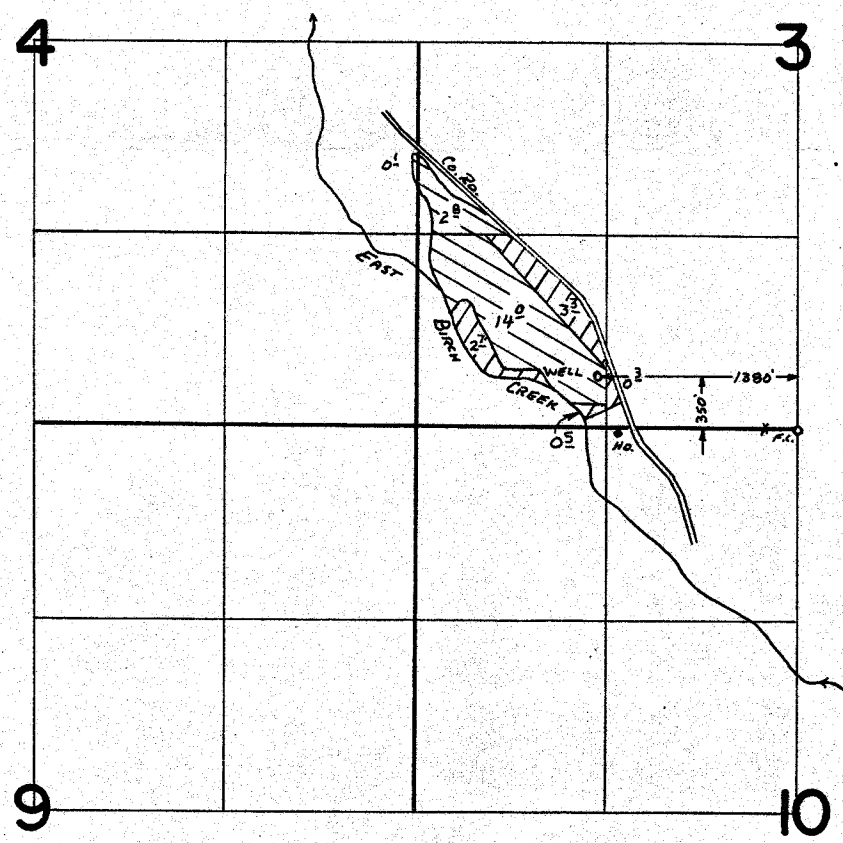

 - PRIMARY
 - SUPPLEMENTAL

FINAL PROOF SURVEY UNDER

Application No. ~~G-4848~~ Permit No. G-4565
IN NAME OF

STEPHEN F. DRAPER

Surveyed APRIL 2 19 75, by L. T. J. L.