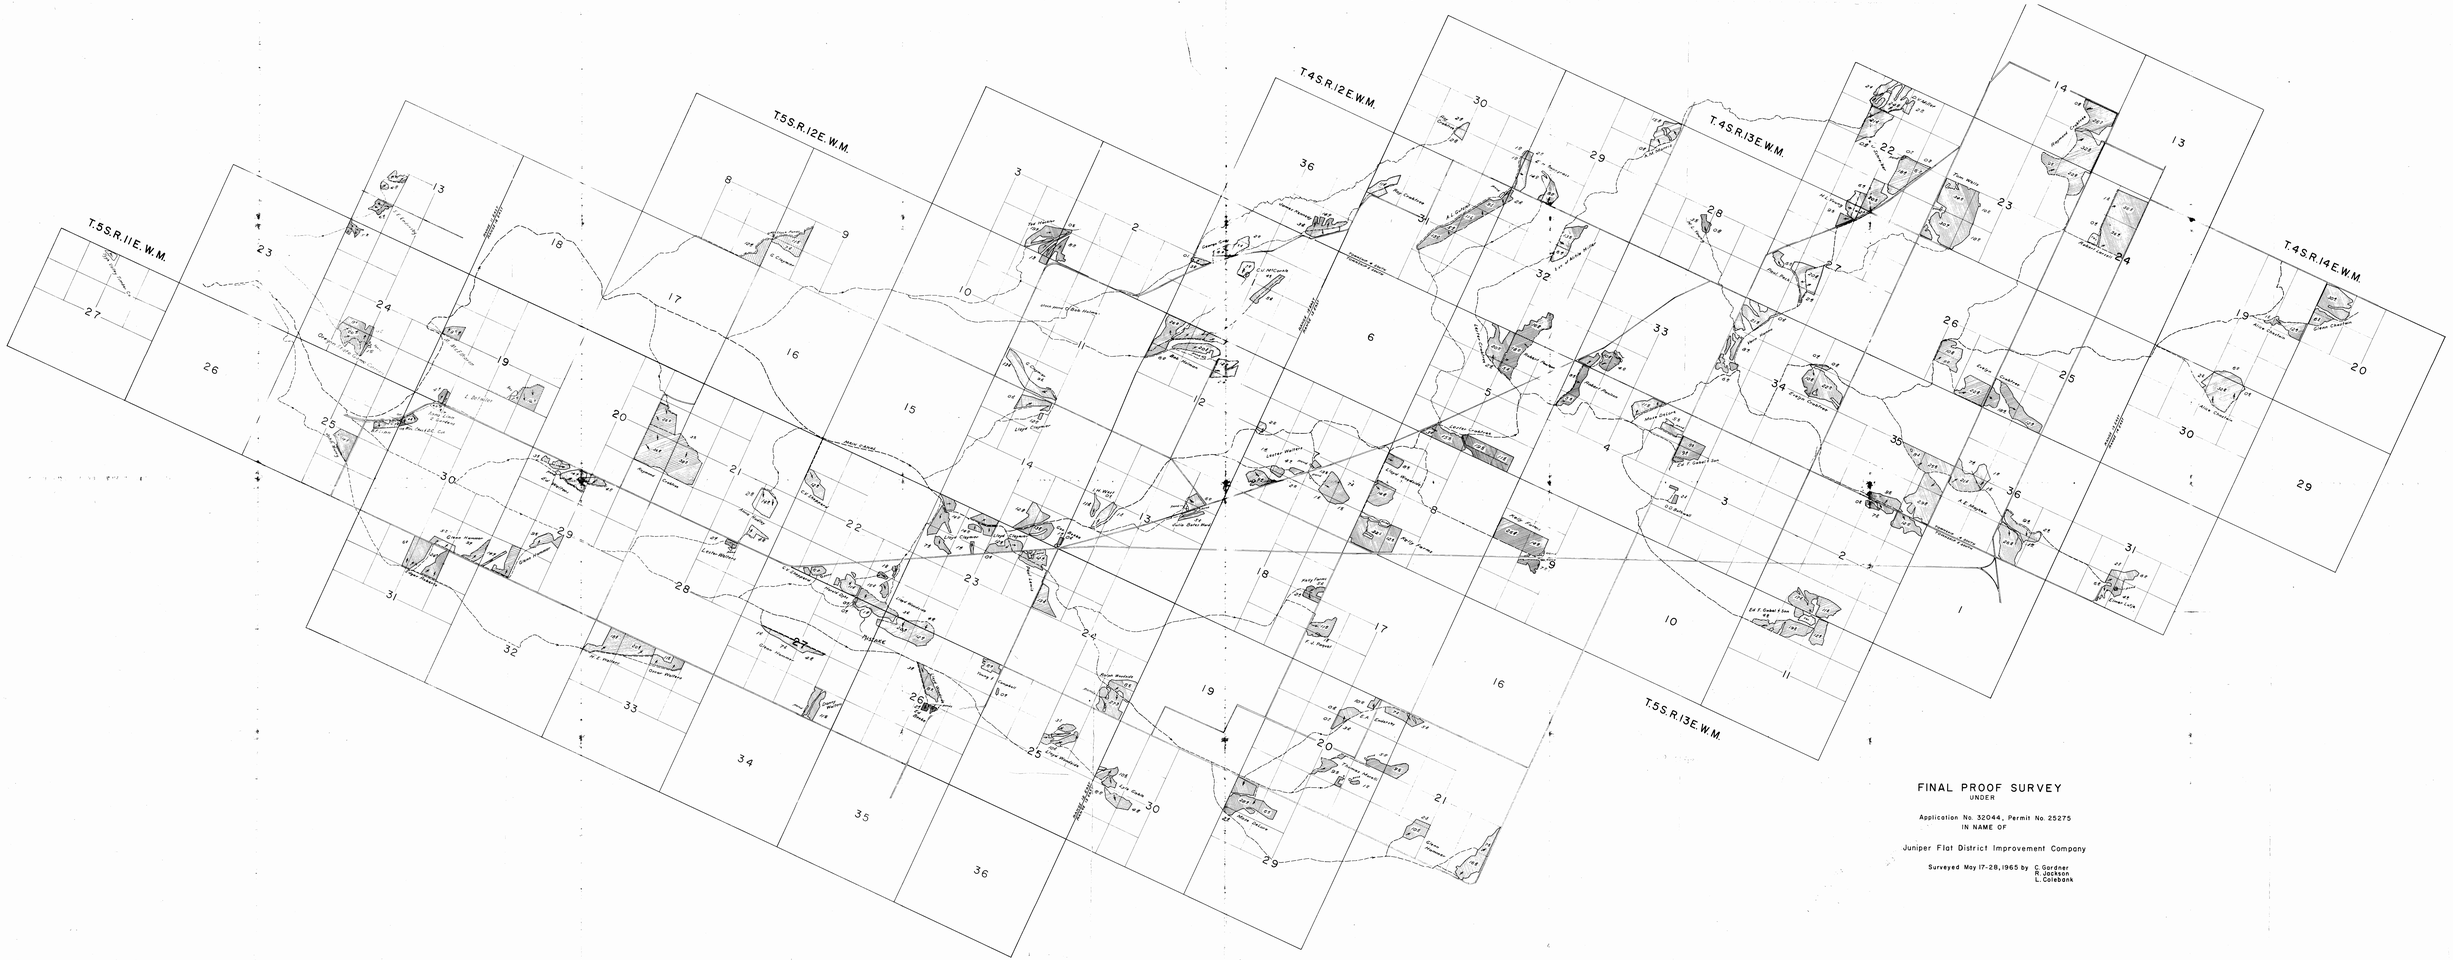

FINAL PROOF SURVEY
UNDER
Application No. 32044, Permit No. 25275
IN NAME OF
Juniper Flat District Improvement Company
Surveyed May 17-28, 1965 by C. Gardner
R. Jackson
L. Colebank