


T.4S.R.5W.W.M.

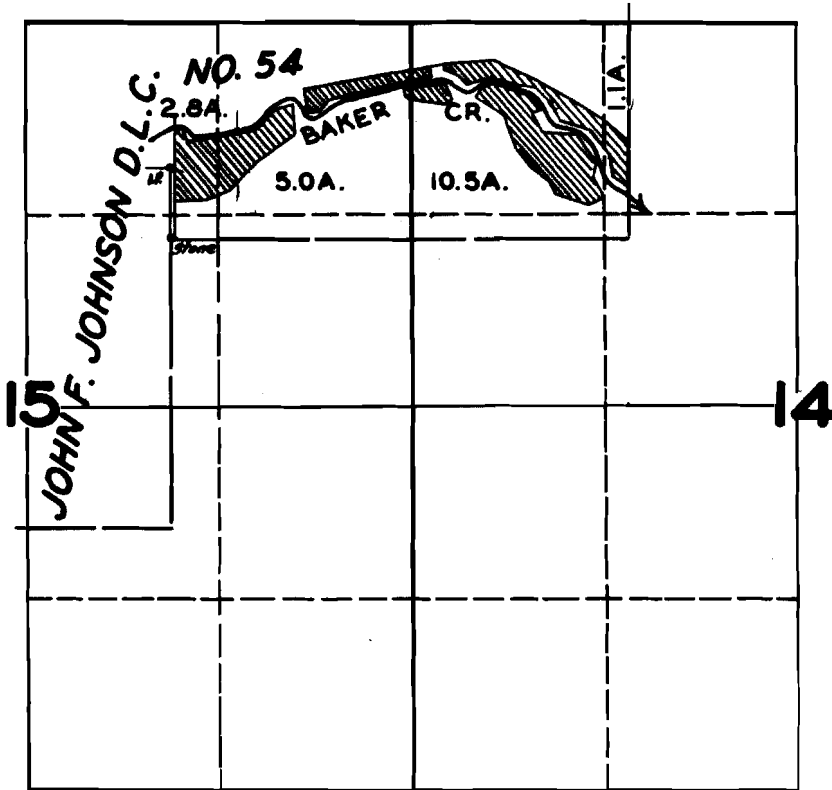

FINAL PROOF SURVEY
UNDER

Application No. **18325** Permit No. **13959**

IN NAME OF

HENRY W. LEVER

Surveyed **MAY 6** 1947, by **JAS. E. BUNNELL**