
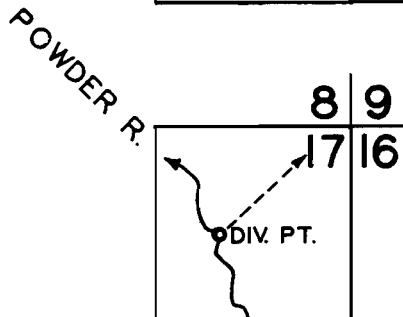


T. 8 S. R. 40 E. W. M.

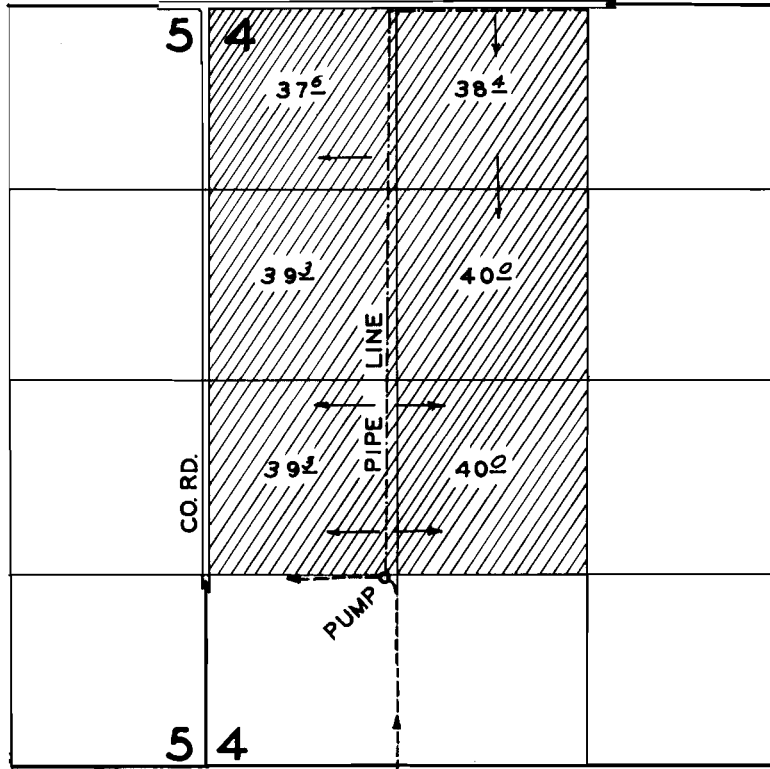

FINAL PROOF SURVEY UNDER

Application No. 32365... Permit No. 25558...
IN NAME OF

CHARLES. M. COLTON

Surveyed SEPT. 13. 19.60. by *R.H. Jackson*