


T.IIS.R.7W., W.M.

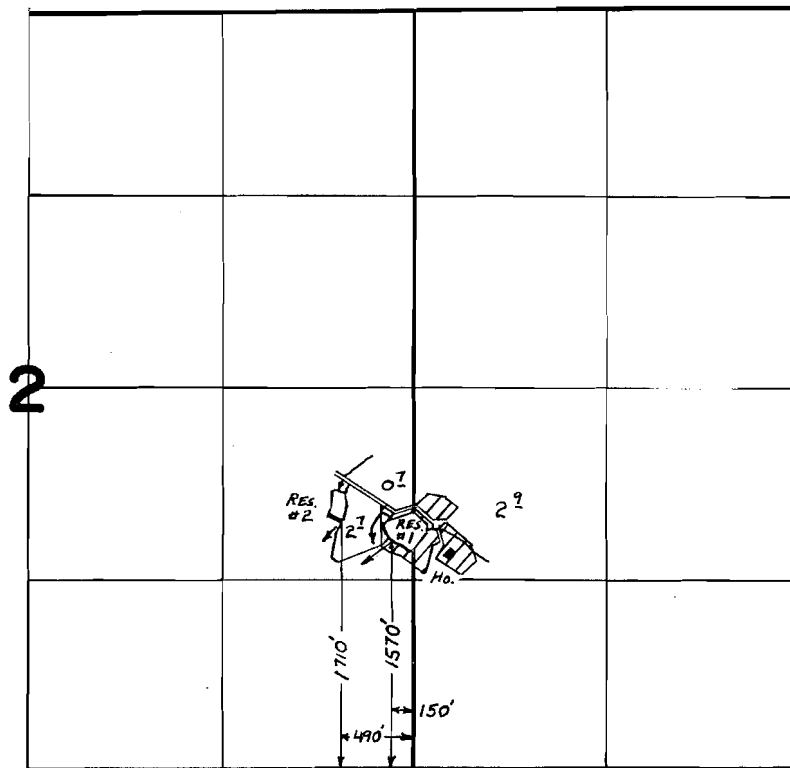

FINAL PROOF SURVEY
UNDER

R-51119 R-6025
51120 37120
R-51290 R-6215
Application No. 51291 Permit No. 38732
IN NAME OF

HAROLD L. SCHUDEL

Surveyed OCT. 10, 1978, by S.P. APPLEGATE