


T.11S.R.7W., W.M.

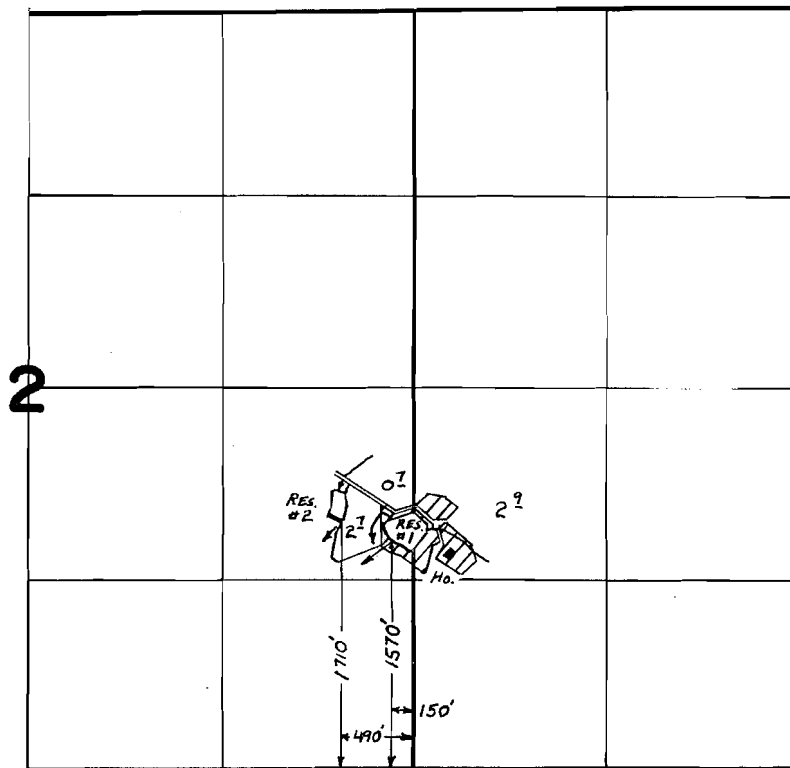

FINAL PROOF SURVEY
UNDER

R-51119	R-6025
51120	37120
R-51290	R-6215
Application No. 51291	Permit No. 38732
IN NAME OF	

HAROLD L. SCHUDEL

Surveyed OCT. 10, 1978, by S.P. APPLEGATE