


T.30S. R.5W. W.M.

Sec. 27

NE1/4 NW1/4

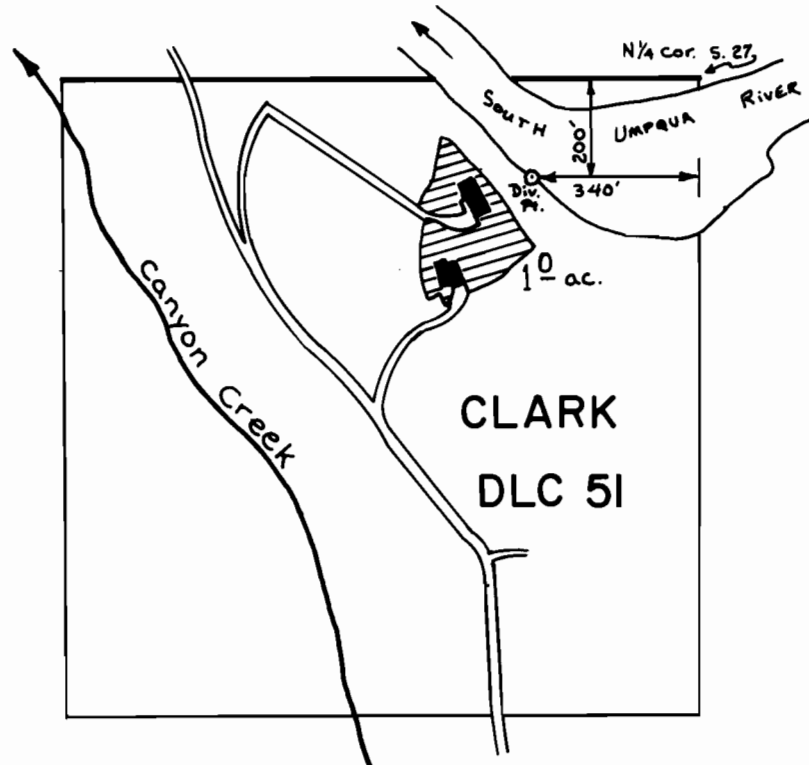

SCALE: 1" = 400'

FINAL PROOF SURVEY
UNDER

Application No. 49467 Permit No. 37054
IN NAME OF

..... James B. Ford

Surveyed Feb. 10 1978, by D. Sparks