


# T.10 S. R. 6 W. W.M.

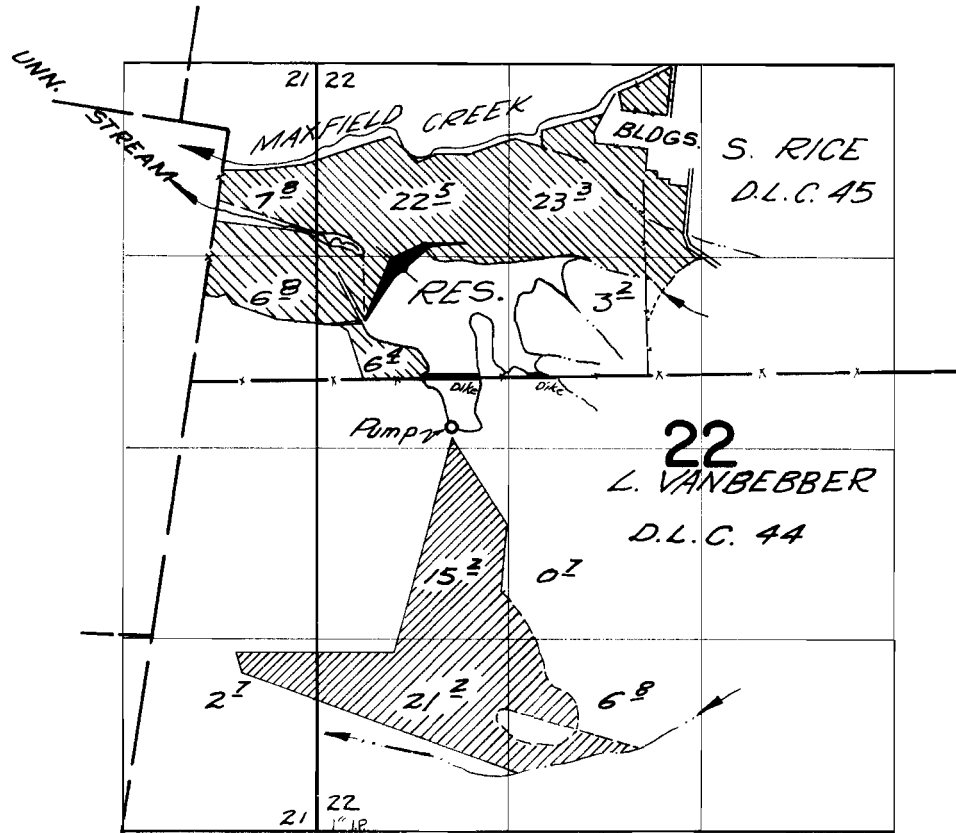

Div. Pt. located 3860 ft. N. & 600 ft. E. from the SW corner of section 22

## FINAL PROOF SURVEY UNDER

R-35052  
35053

R-2862  
27920

Application No. 37298 Permit No. 27929

IN NAME OF

EMERY E. MOORE

Surveyed April 14, 1966, by V. GARNER

