


T. 13 & 14 S. R. 5 W. W. M. .

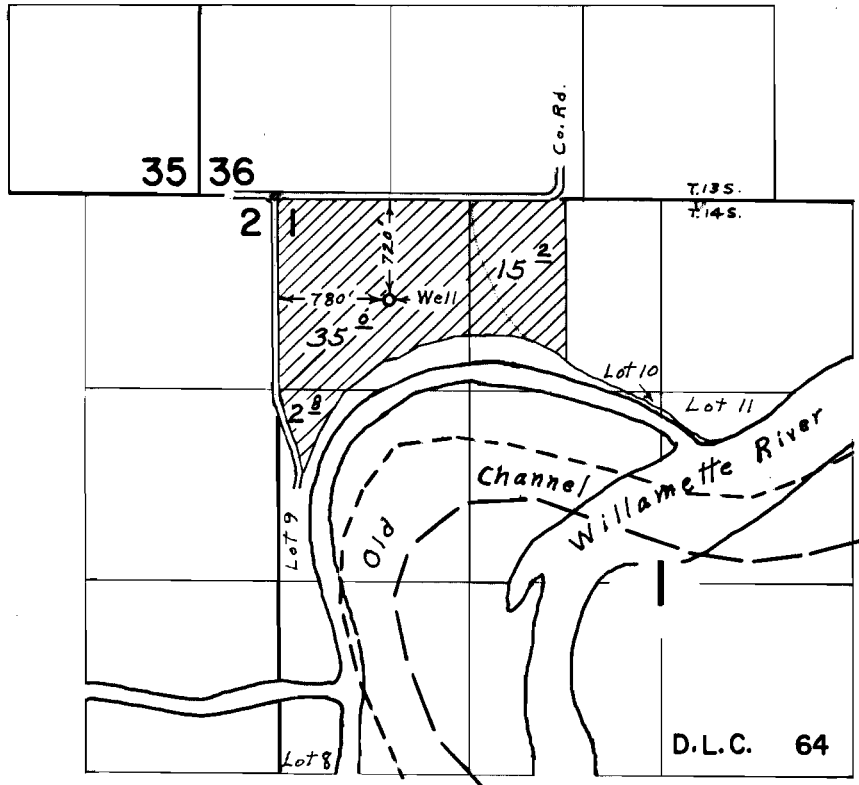

FINAL PROOF SURVEY
UNDER

Application No. G-3835 Permit No. G-3615
IN NAME OF

IVAN HORNING

Surveyed March 26, 1970, by L. E. Gould