


T.32S. R.15W. W.M.

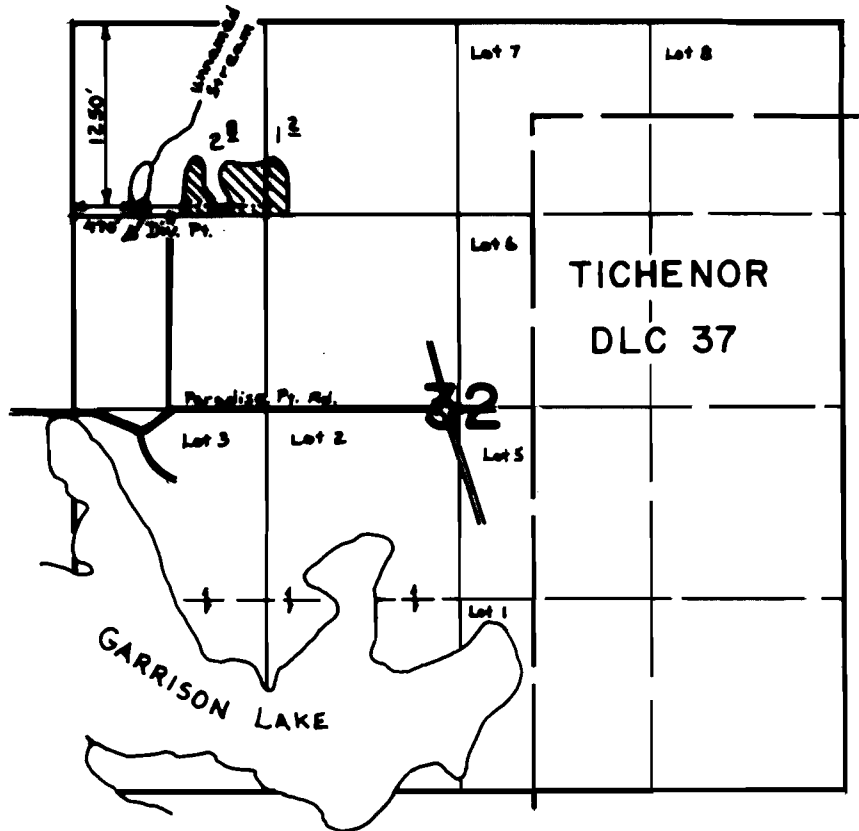

SCALE : 4" = 1 mile

FINAL PROOF SURVEY

UNDER

Application No. 54525 Permit No. 40894
IN NAME OF

DARYL C. ROBISON

Surveyed June 27, 1979, by S. Donaldson...