


T.25S.,R.5W.,W.M.

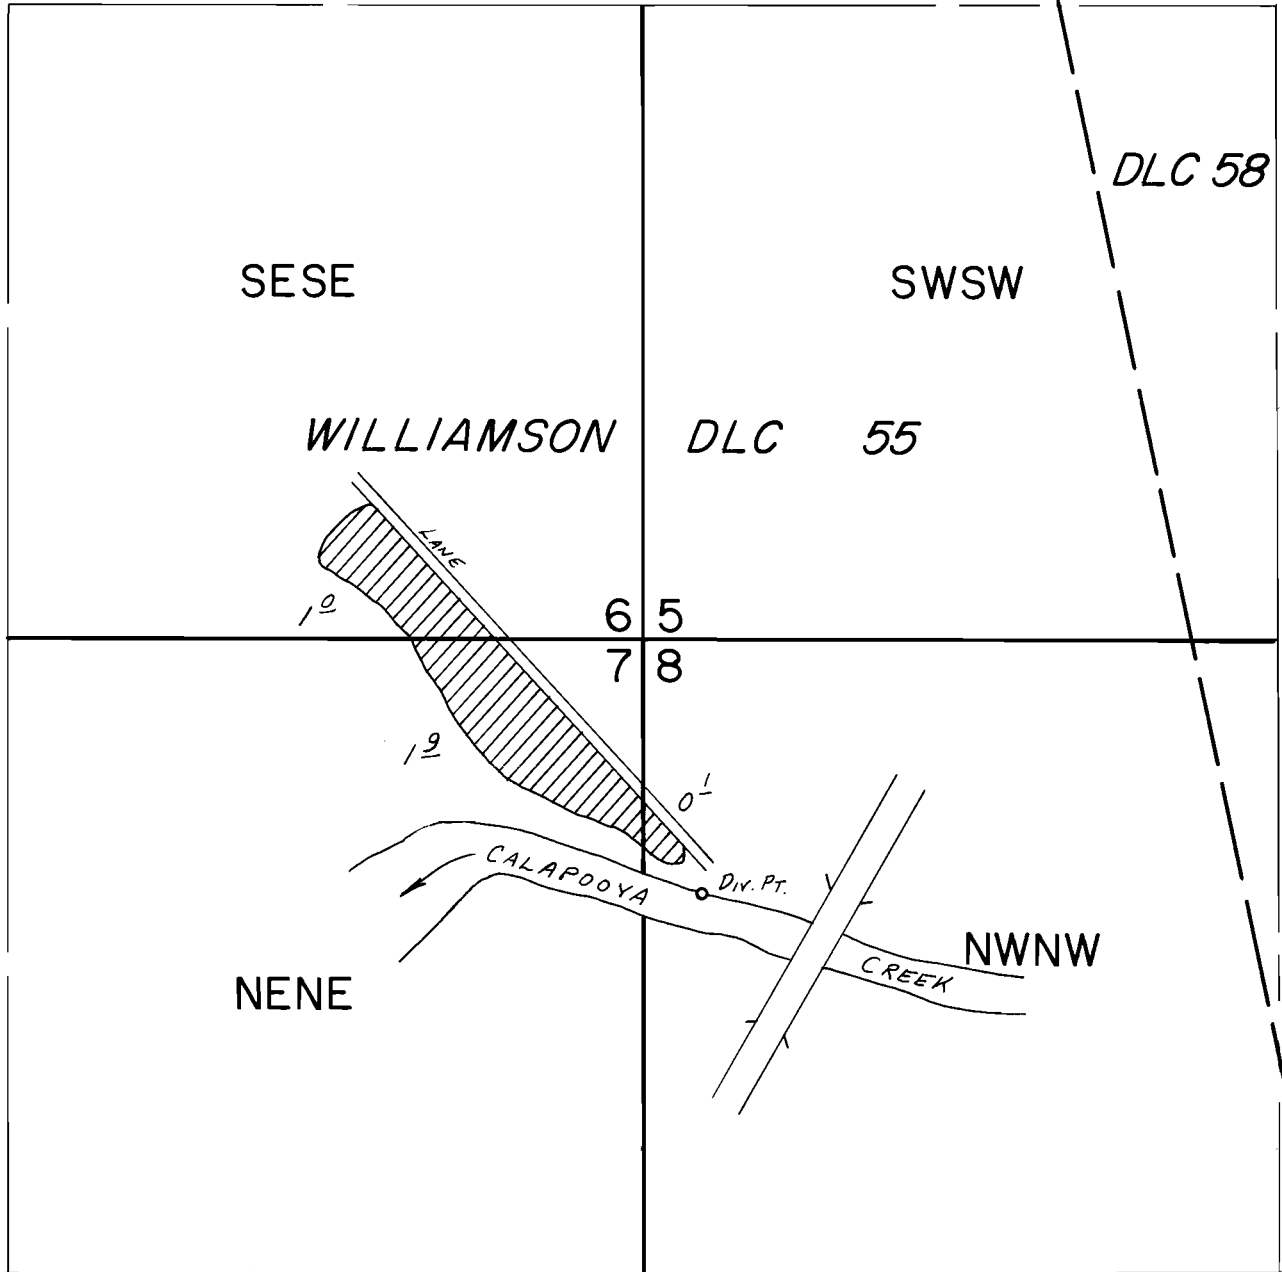

Div. Pt. Loc.: 530'S. & 120'E. FROM NW COR. SEC. 8.

SCALE: 1" = 400'

FINAL PROOF SURVEY

UNDER

Application No. 51284... Permit No. 38728.....
IN NAME OF

.....Kenneth L. & Julia A. Green.....

Surveyed MAY 28... 19.80, by J.S. DONALDSON