


T. 26S., R. 7W., W.M.

SEC. 24

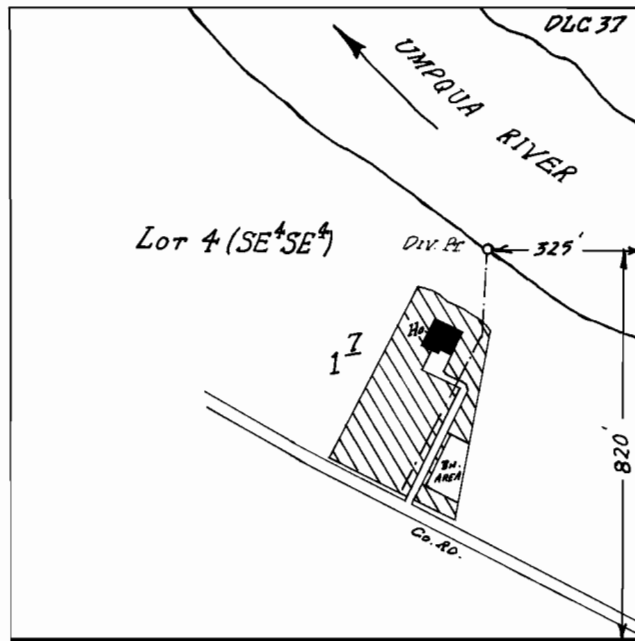

SCALE: 1" = 400'

FINAL PROOF SURVEY
UNDER

Application No. 51310..... Permit No. 38741.....
IN NAME OF

.....RALPH F. JAEGER.....

Surveyed MAY 3..... 19.79, by J.S. DONALDSON