


T. 23S. R. 32 1/2 E. W.M.

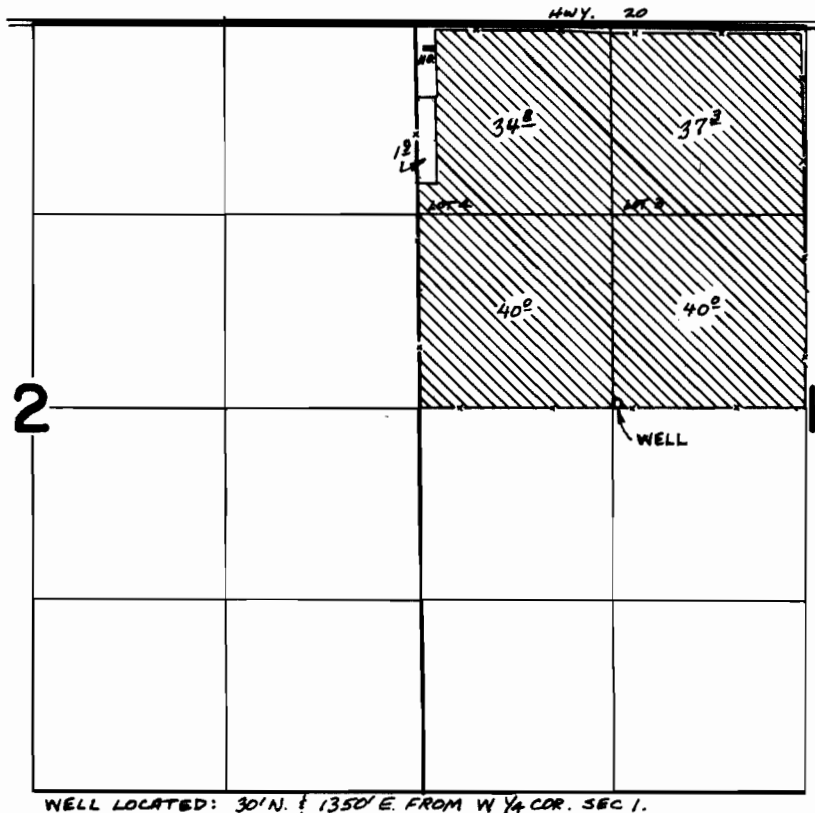

WELL LOCATED: 30' N. & 1350' E. FROM W 1/4 COR. SEC 1.

FINAL PROOF SURVEY
UNDER

Application No. G-4985 Permit No. G-4703
IN NAME OF

Farris B. Benton

Surveyed JUNE 17, 1975, by L. TOLL
OCT. 8, 1981 by L. TOLL