


T.35S., R.2W., W.M.

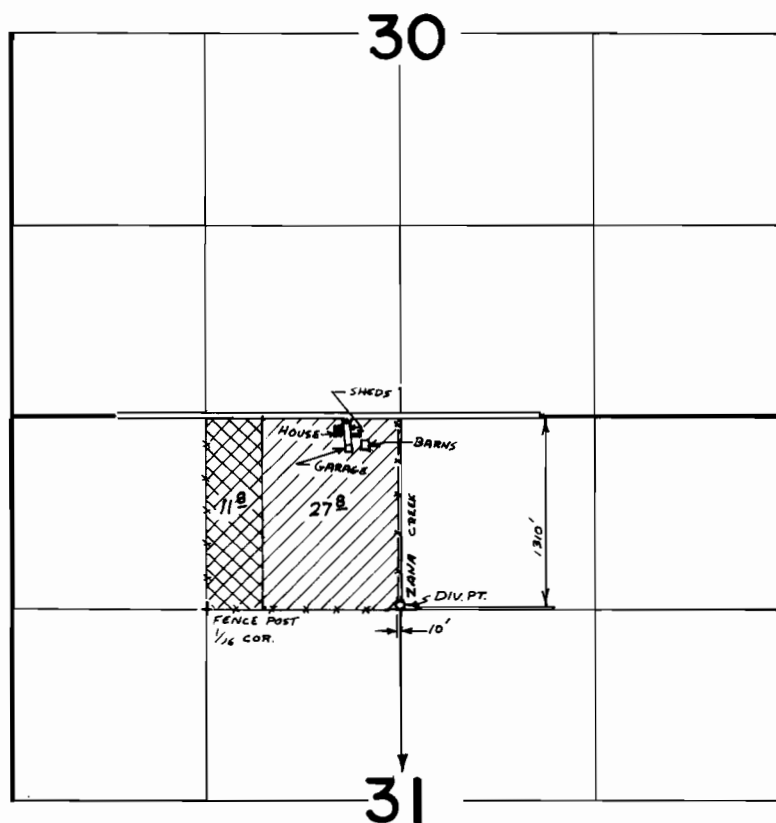

SAMS VALLEY RES. - 2880'N & 1290'E FROM
SW COR. SEC. 18.

Scale : 4" = 1 Mile

PRIMARY

SUPPL.

FINAL PROOF SURVEY UNDER

Application No. 57553. Permit No. 43350....
IN NAME OF

..... DALE P. SCHULZ

Surveyed Nov. 2, 1978, by BRUCE R. SUND