

27

26

25

CREEK

CHERRY

34

35

36



15


14


Surveyed Sept. 7 & 8, 1926.

22

23

no river, except in the
old land, sketched in
on.

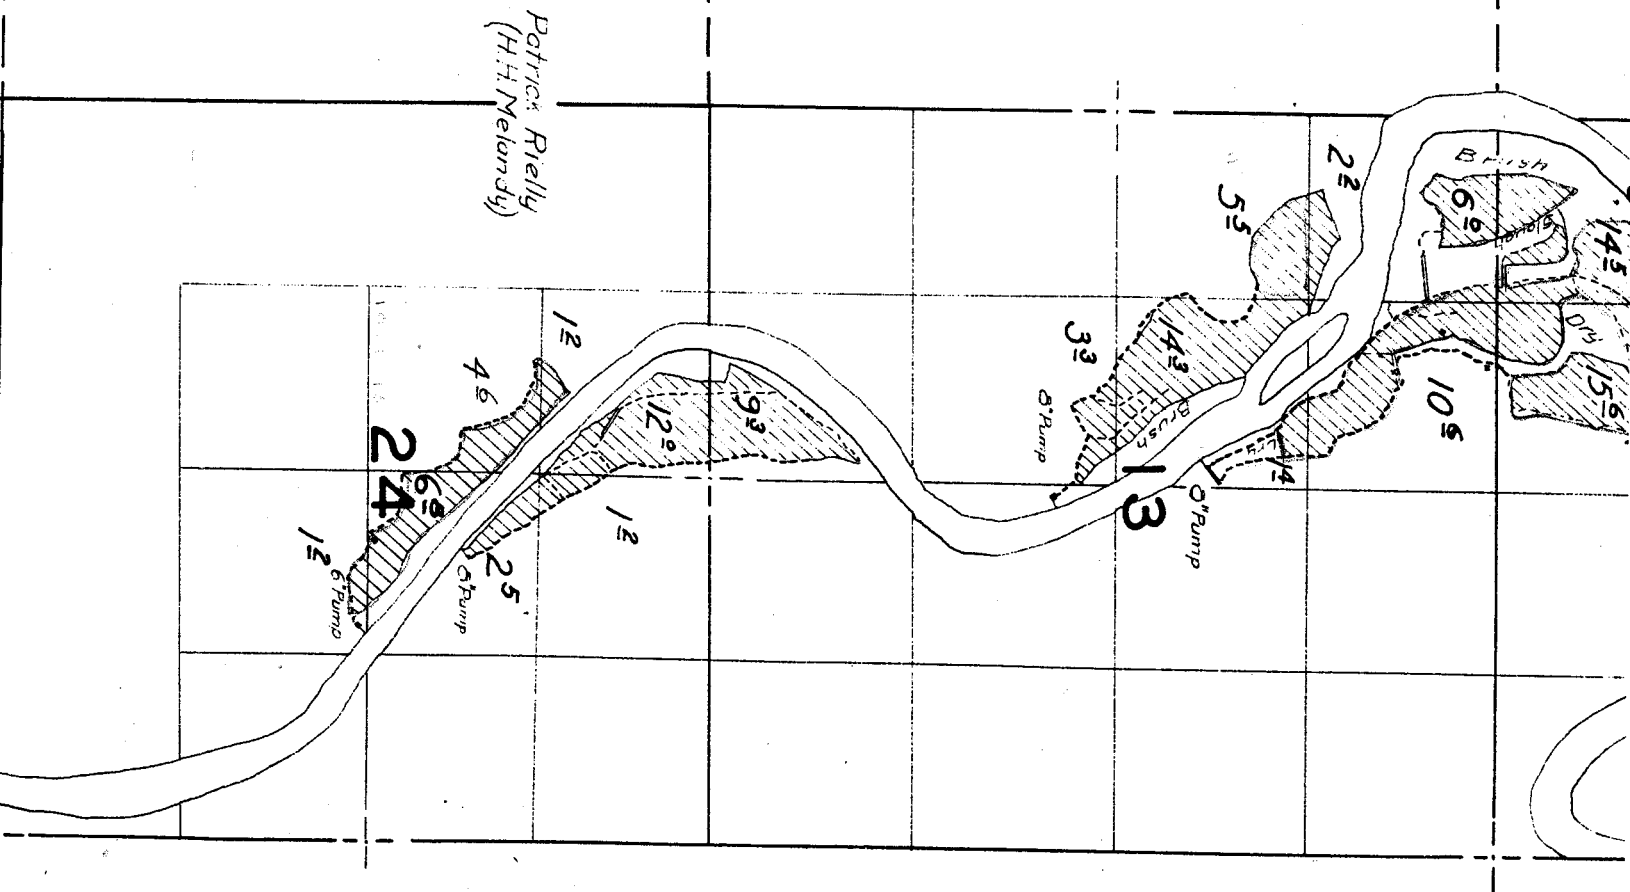

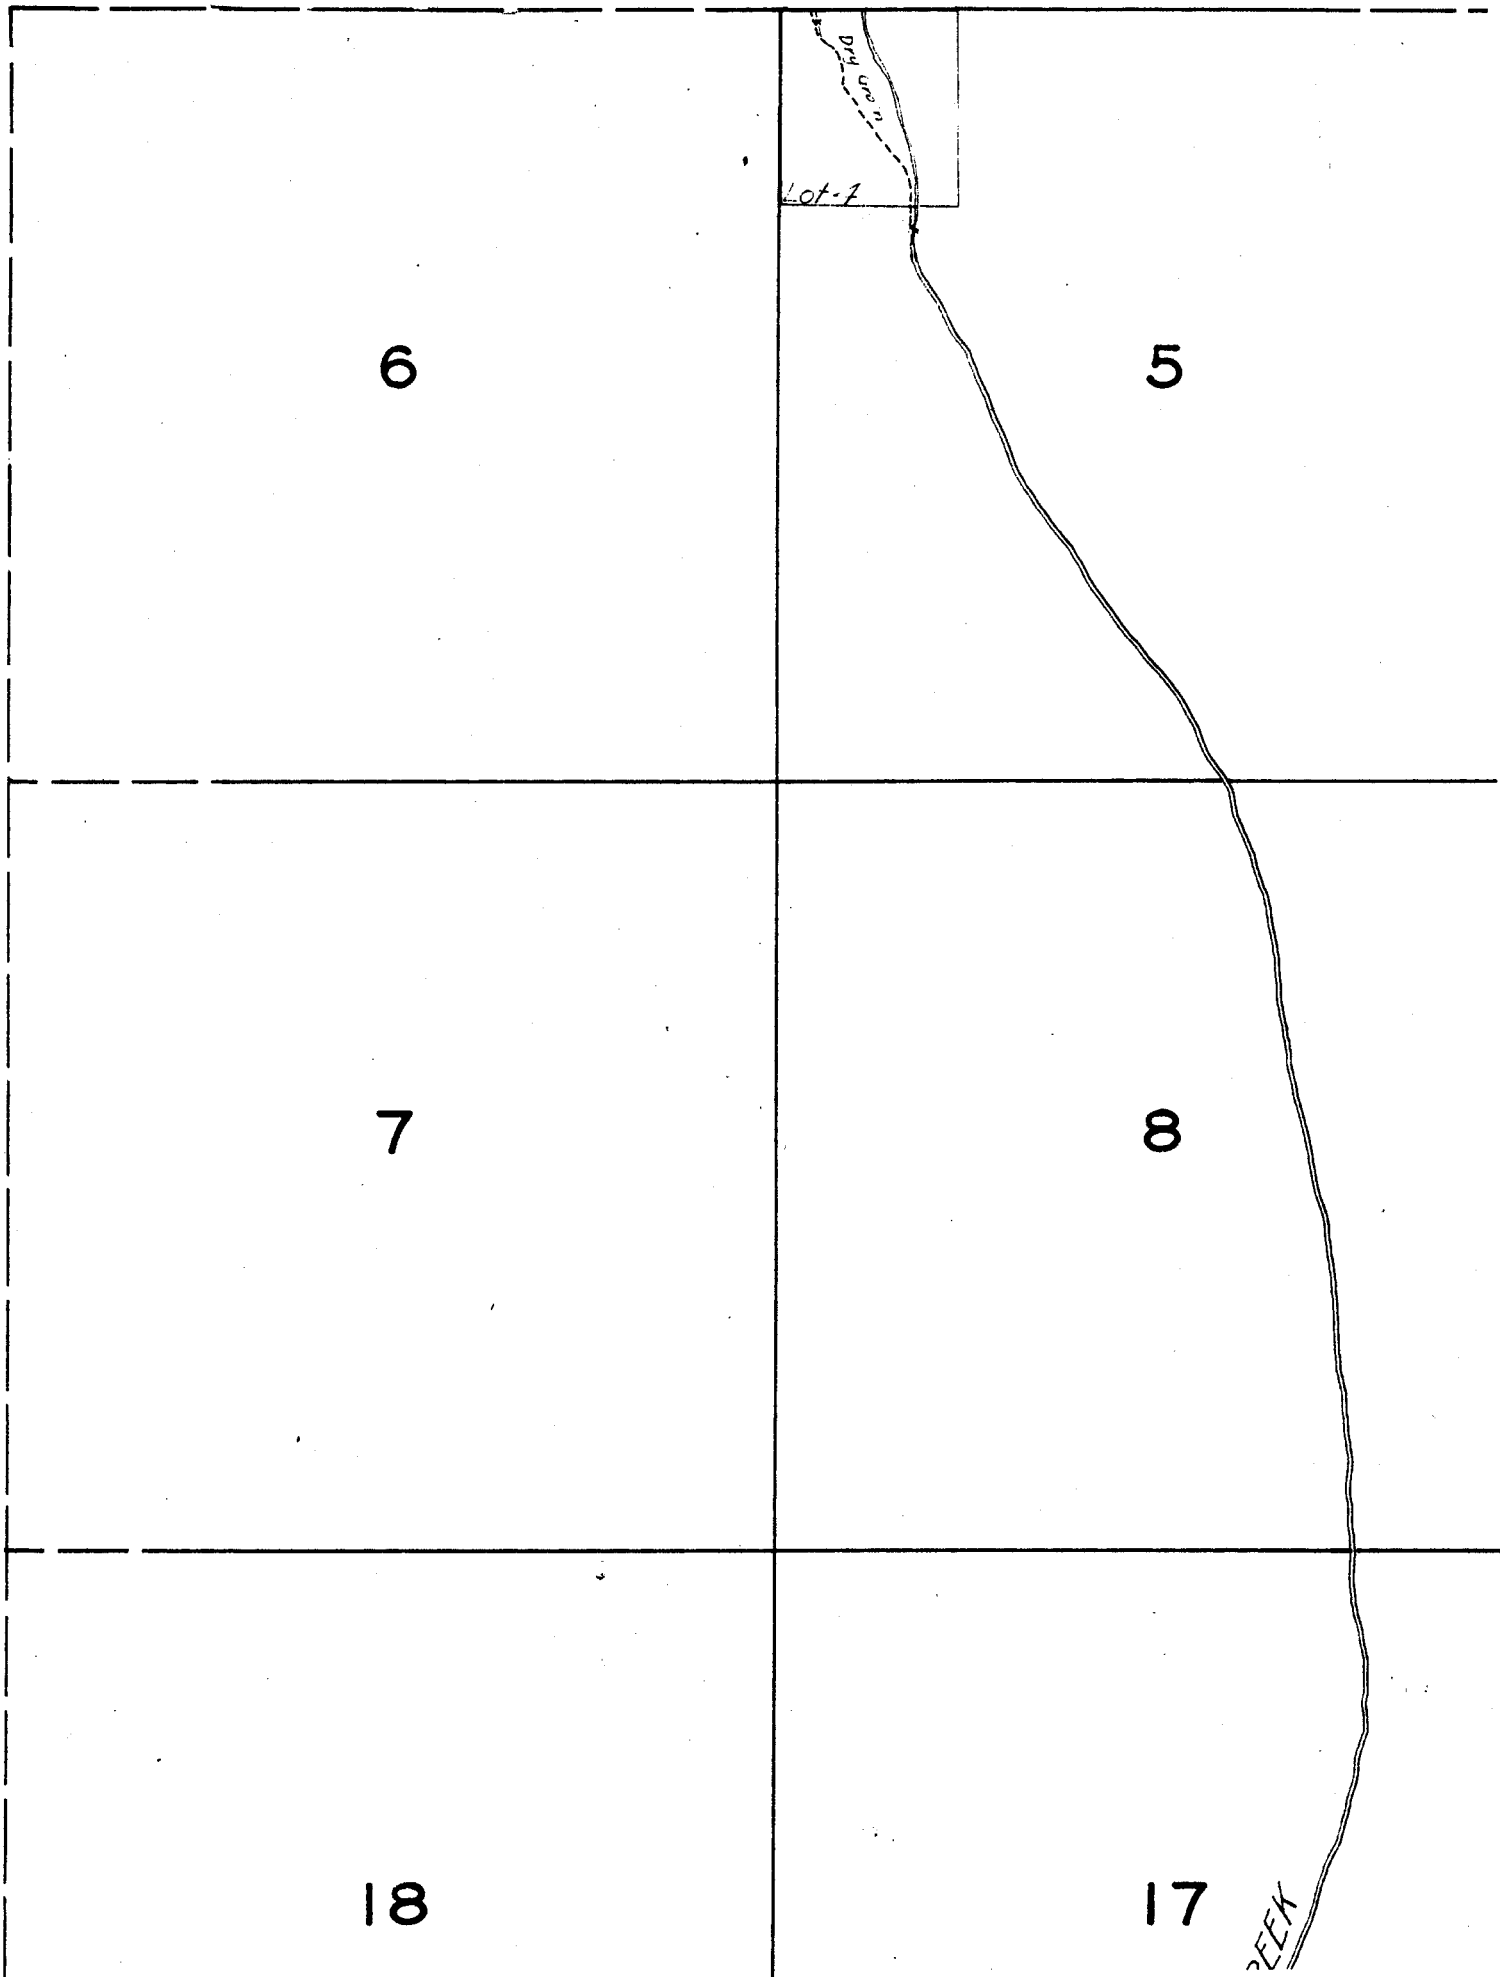

6

5

7

8

18

17

DECK


2

1

11

12

14

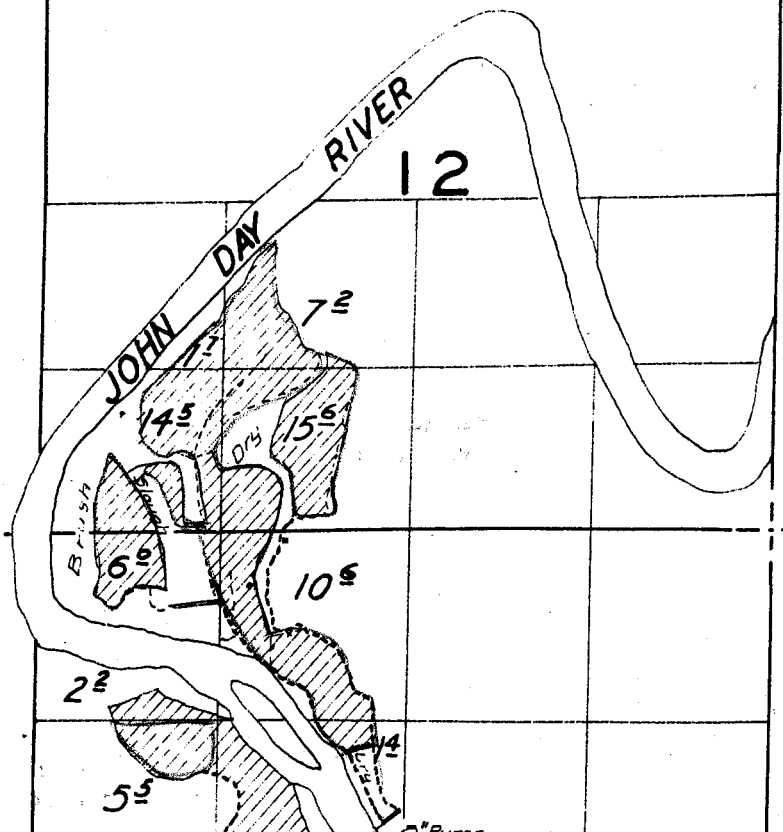

21

22

NOTE: Streams and river, except in the vicinity of irrigated land, sketched in approximate location.

28

27

33

34

CHERRY

TOWNSHIP 9 S. RANGE 19 E.

4

3

9

10

CEK

16

15

Surveyed Se

21

22

NOTE: Streams and river, except in the vicinity of irrigated land, sketched in approximate location.

Surveyed Aug. 27, 1926.

Lot 2

Junipers

0.3

30.0.3

Lot 3

11.5

Flume

1.6

3.1

Prineville Land & Livestock Co
James Scott (Supt)

Lot 4

29

28

31

32

33

Surveyed Aug 27, 1926.

18

19

17

CREEK

20

MUDDY

16

21

