


SUPPLEMENTARY MAP
 APP. NO. 12008
 PER. NO. 8404
 Filed Apr. 19, 1930

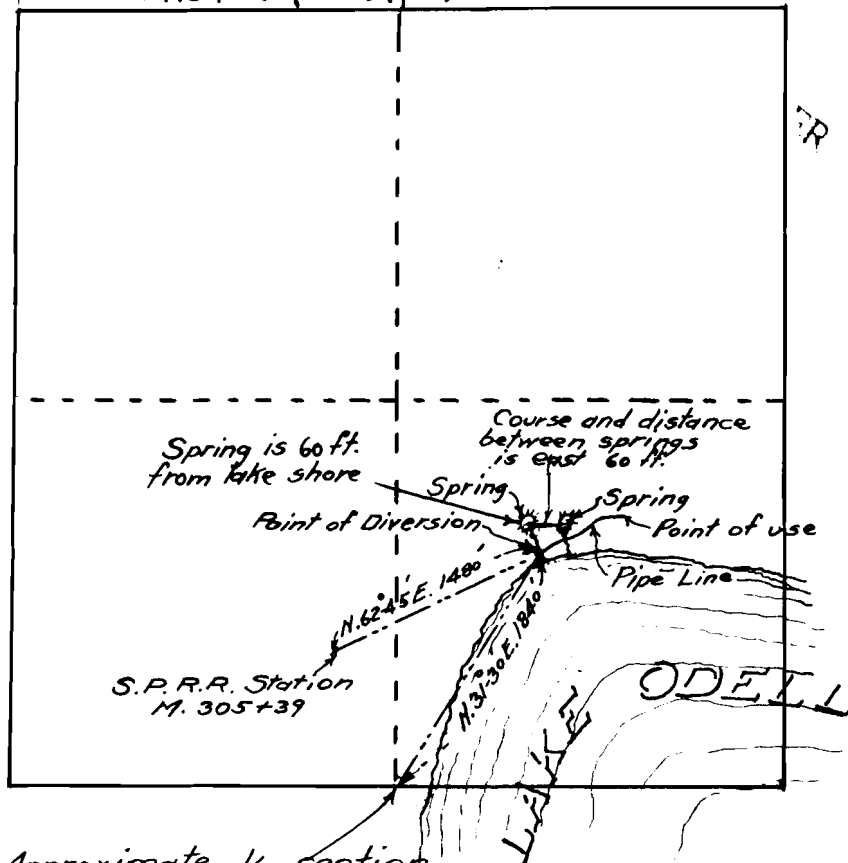

Approximate $\frac{1}{4}$ section
 corner between sections
 #7 & #18, T. 23 S. R. 6 E., W. 1 M.
 (Unsurveyed)

MAP TO ACCOMPANY APPLICATION OF
 Otto C. Stein
 Scale 4 in. = 1 mile. Apr. 17, 1930.

C-9220
 51589

8404