


T.20S. R.5W., W.M.

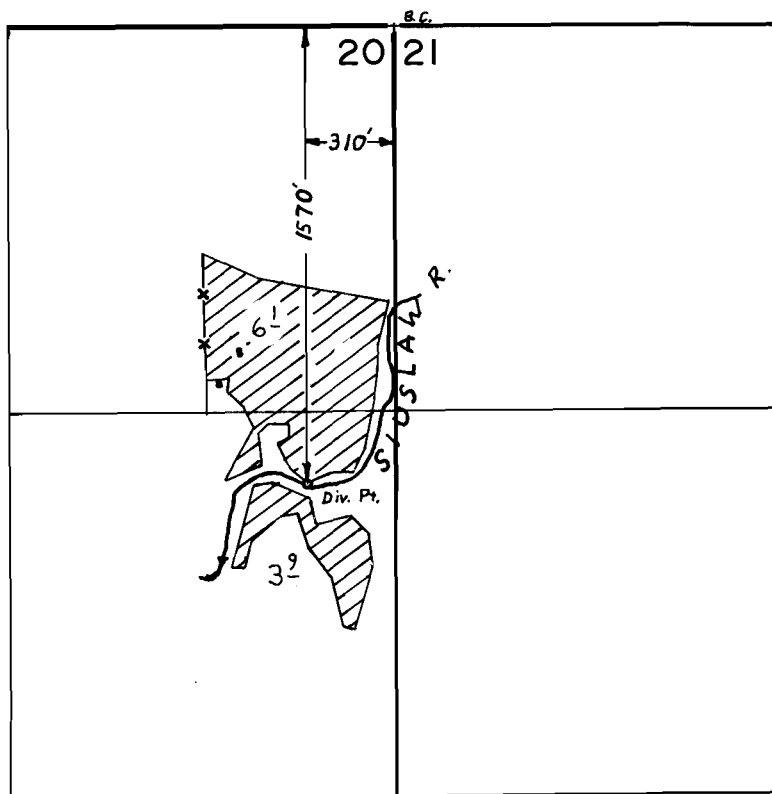

Scale: 1" = 660'

FINAL PROOF SURVEY UNDER

Application No. 50511..... Permit No. 36771.....
IN NAME OF

.....STANLEY D. BELDEN.....

Surveyed MAR. 29, 1978, by J.S. DONALSON
July 13, 1982 L. M. TOLL