


T.22S. R.3W. W.M.

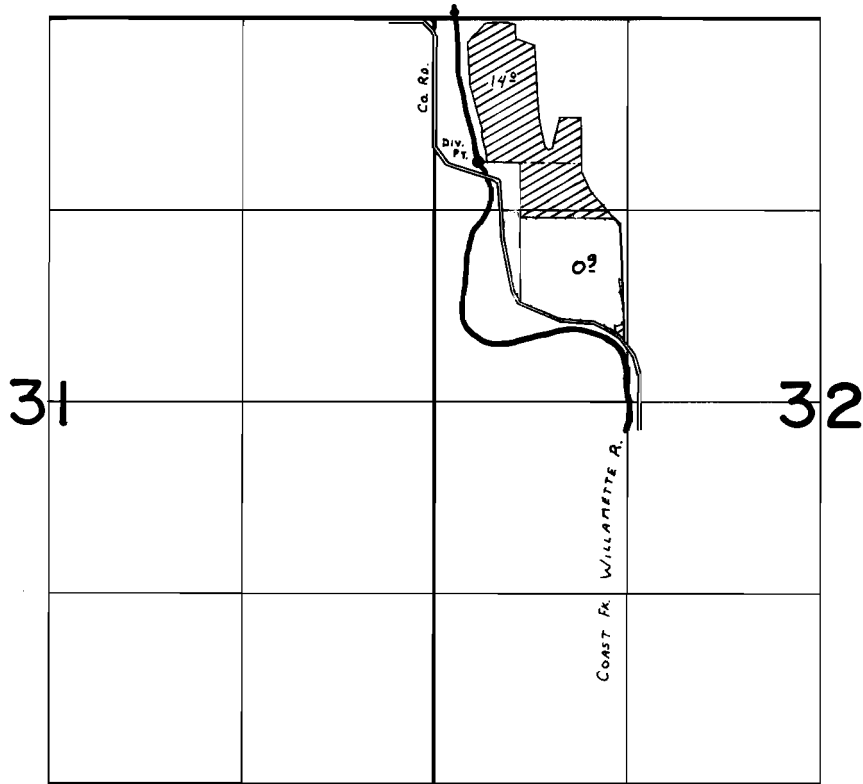

Div. Pt. Loc: 980'S. & 300'E. fr. N.W. Cor. Sec. 32.

- ▨ - T-3233
- ▨ - App. 53163

FINAL PROOF SURVEY
UNDER

Transfer No. 3233
Application No. 53163... Permit No. 38789.....
IN NAME OF

.....THOMAS H. RASMUSSEN.....

Surveyed June 18, 1980, by C. L. Hughes.....