


T.17S.,R.6W.,WM.

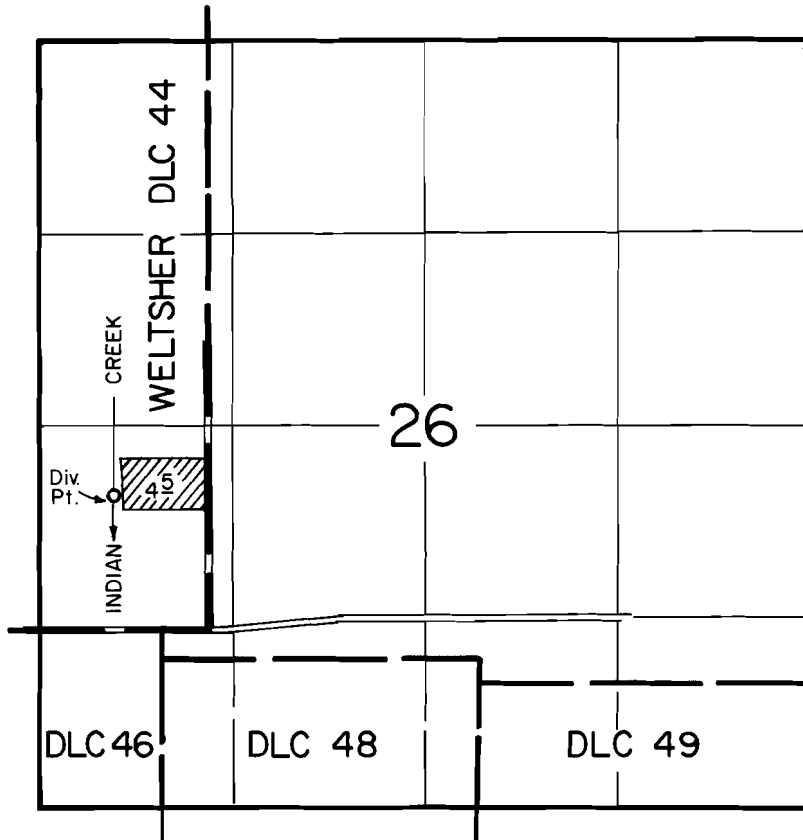

Div. Pt. Loc: 930' N. & 640' W. from the SE corner DLC 44

FINAL PROOF SURVEY
UNDER

Application No. 54563 Permit No. 40942
IN NAME OF

Larry R. & Shara L. Davis

Surveyed MAY 6, 1980, by ABrown