


T.I.S. R.I.O.W. W.M.

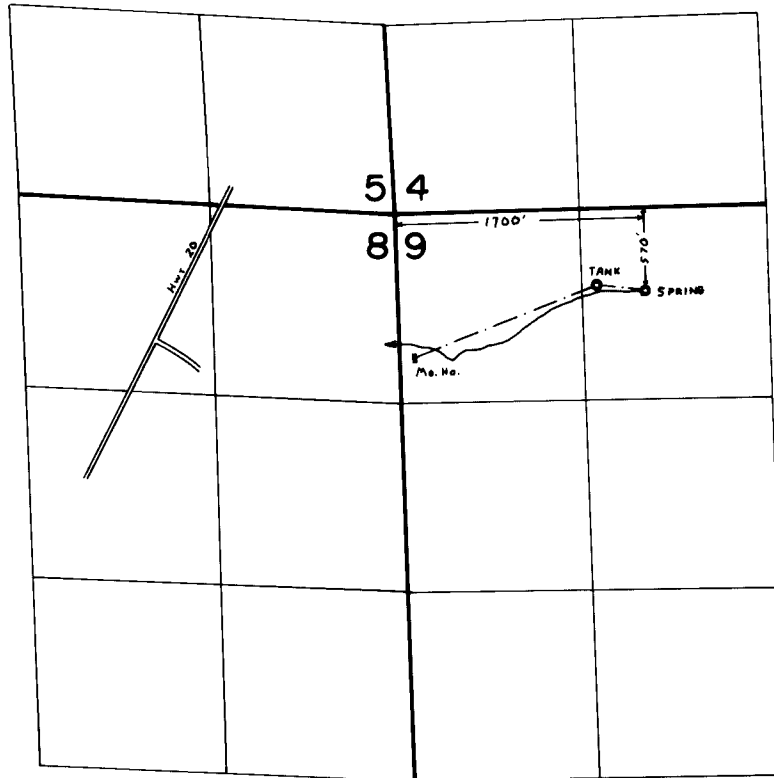


FINAL PROOF SURVEY
UNDER

Transfer No. 4064
Application No. Permit No.
IN NAME OF

..... **LUCILLE GREGORY**

Surveyed May 23, 1980, by C. L. Hughes.....

T.I.S. RIOW. W.M.

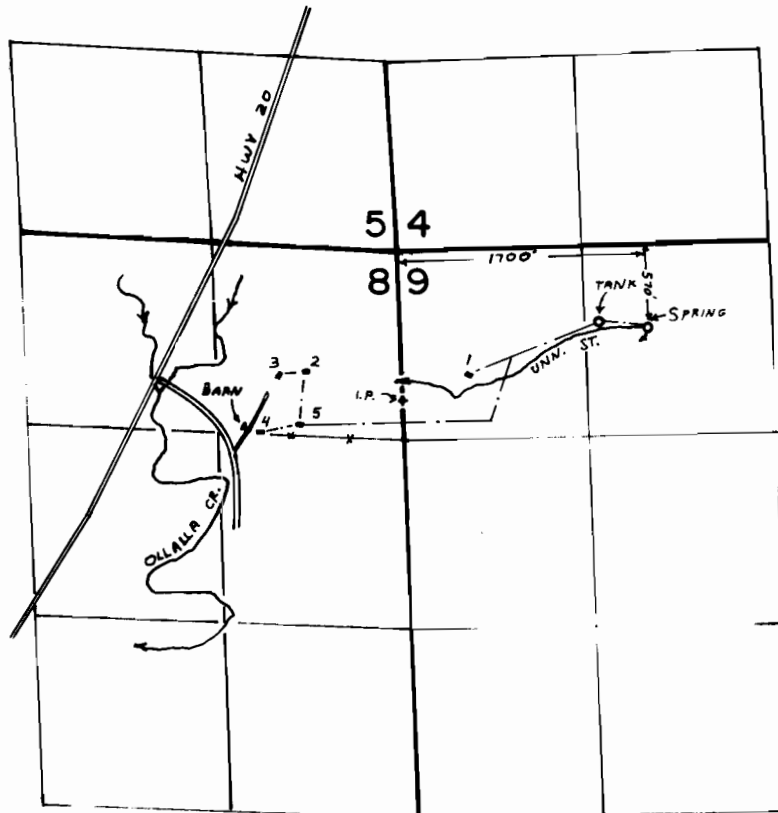

HOUSES 1 & 2 GREGORY
HOUSES 4 & 5 M. JOHNSON
HOUSE 3 K. JOHNSON

FINAL PROOF SURVEY
UNDER

Application No. 49549... Permit No. 37087...
IN NAME OF

JAMES & LUCILLE GREGORY

Surveyed OCT. 24, 1978, by C. R. KING