



T.4S. R.2W., W.M.

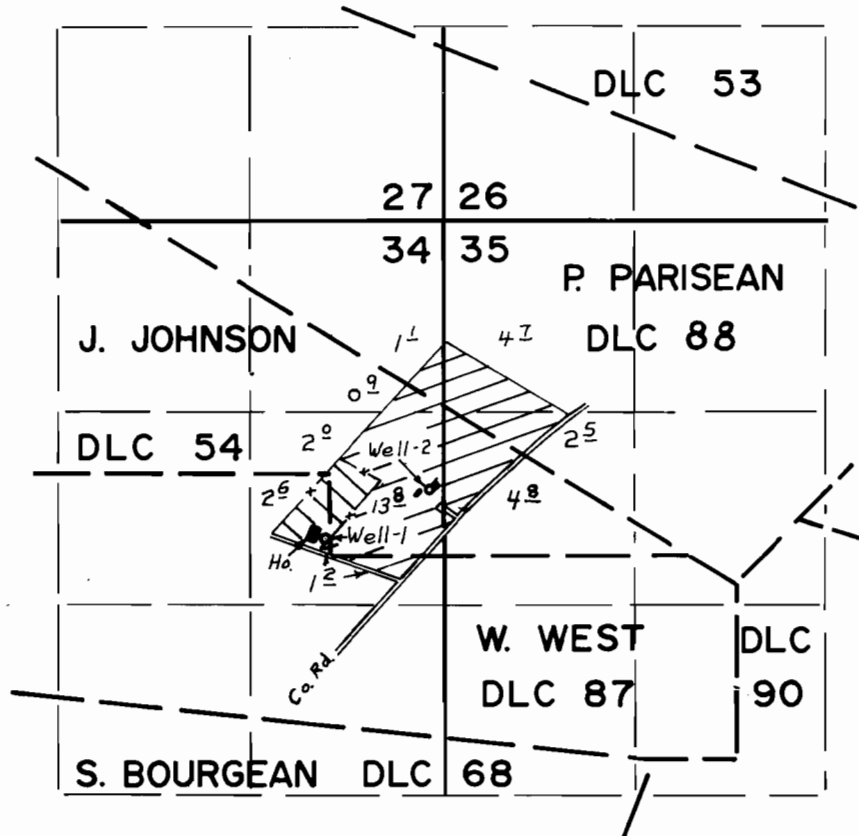

Well-1 Loc. 130' N. & 30' W. From S'ly S.W. Cor. DLC 54
 Well-2 Loc. 450' N. & 680' E. From S'ly S.W. Cor. DLC 54

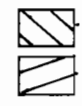

FINAL PROOF SURVEY UNDER

Application No. G-7092. Permit No. G-6560.
 IN NAME OF

.....BETTY JO SIGLER.....

Surveyed AUG. 15. 1977, by E. R. SUND.....
 JUL 10 1980 C. L. HUGHES