


T.4S. R.2W. W.M.

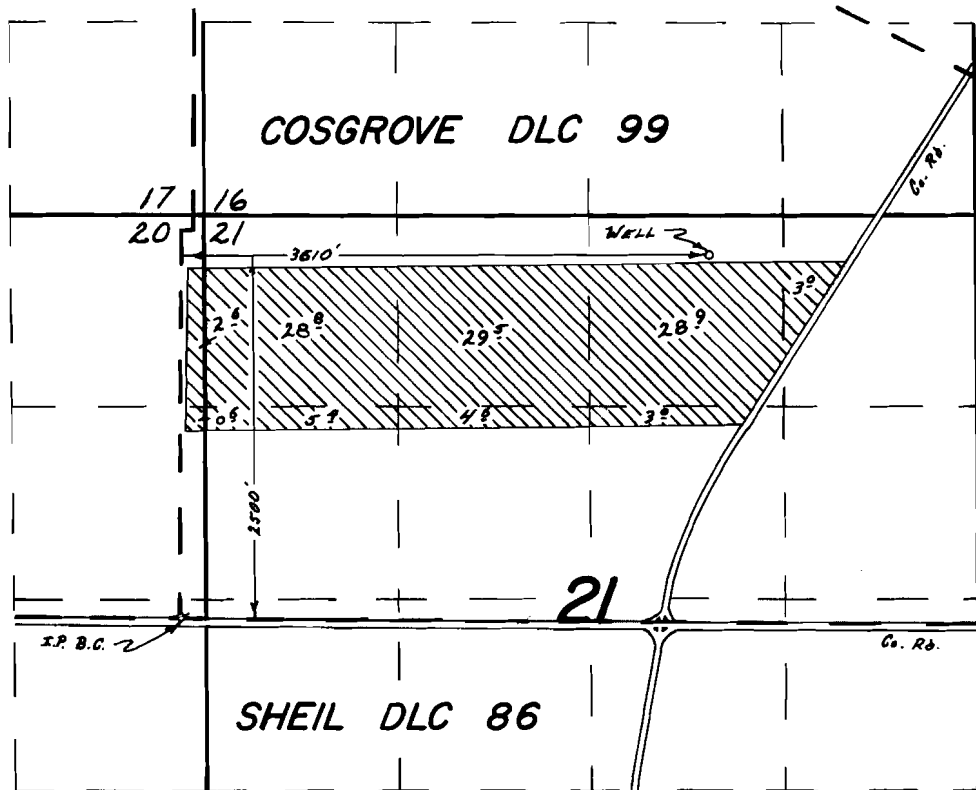

FINAL PROOF SURVEY
UNDER

Application No. G-5241 Permit No. B-5097
IN NAME OF

EDWARD T. BRENTANO

Surveyed June 18 1973, by R. D. MUCKEN