


G-5453
51606

T. 2N. R. 33E. W.M.

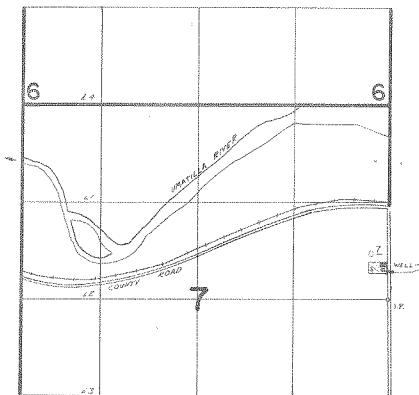

WELL LOC. 920' N / 60' W FROM E/4 COR SEC 7

**FINAL PROOF SURVEY
UNDER**

Application No. G-5607 Permit No. G-5453
IN NAME OF

..... WILLARD D. WOODS

Surveyed 3-2..... 1979.. by K. CHURCH.....