


T. 4N., R. 28E., W.M.

S1607  
L1850  
L7322

27

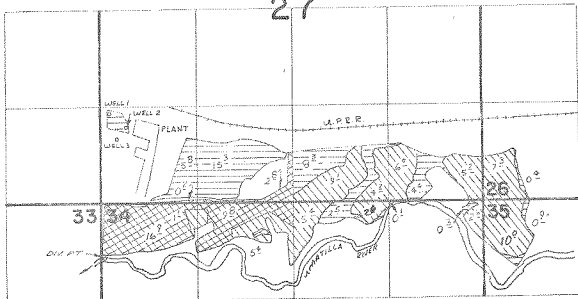

DISSECTION POINT LOCATED 750' S. & 50' E. FROM NW COR. SEC. 34  
WELL 1 LOCATED 1230' N. & 130' E. FROM SW COR. SEC. 27  
WELL 2 LOCATED 1030' N. & 340' E. FROM SW COR. SEC. 27  
WELL 3 LOCATED 880' N. & 230' E. FROM SW COR. SEC. 27



PER. 37853 PRIMARY



PER. G-7077 PRIMARY



PER. G-7077 SUPPLEMENTAL

**FINAL PROOF SURVEY**

UNDER

TRANSFER 3036

50554 & 37853

Application No. G-7168 Permit No. G-7077  
IN NAME OF

J. R. SIMPLOT CO.

Surveyed 8-11-1978 by R. BARWIN  
10-26-1978 R. Barwin  
9-27-1979 U. Church

R3-12  
N2-11M-138 V.C.