


T.4S.,R.12E.,W.M.

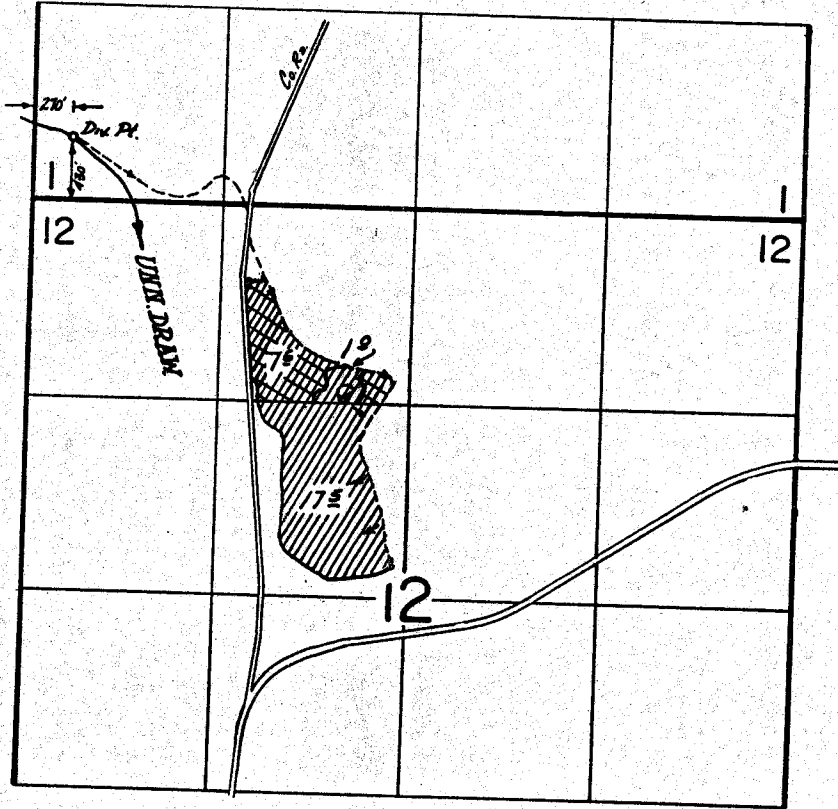

FINAL PROOF SURVEY
UNDER

Application No. 50541 Permit No. 37317
IN NAME OF

JAY L. MAHAFFEY

Surveyed April 8 1976, by R.G. Mucken