


T. 6 S., R. 7 W., W.M.

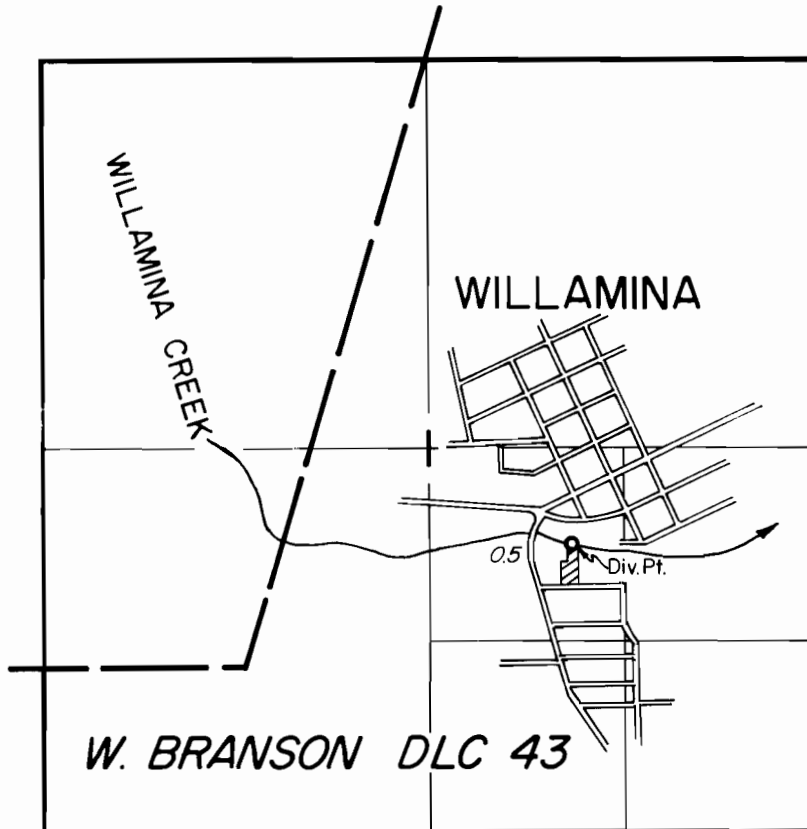

DIV. PT. LOC: 1980' N. & 1680' W., from the SE corner Section 1

FINAL PROOF SURVEY UNDER

Application No. 52953 Permit No. 39976
IN NAME OF

.....Victor E. Johnson.....

Surveyed JUNE 1, 1979, by *[Signature]*.....