


T. 8S. R. 45E. W.M.

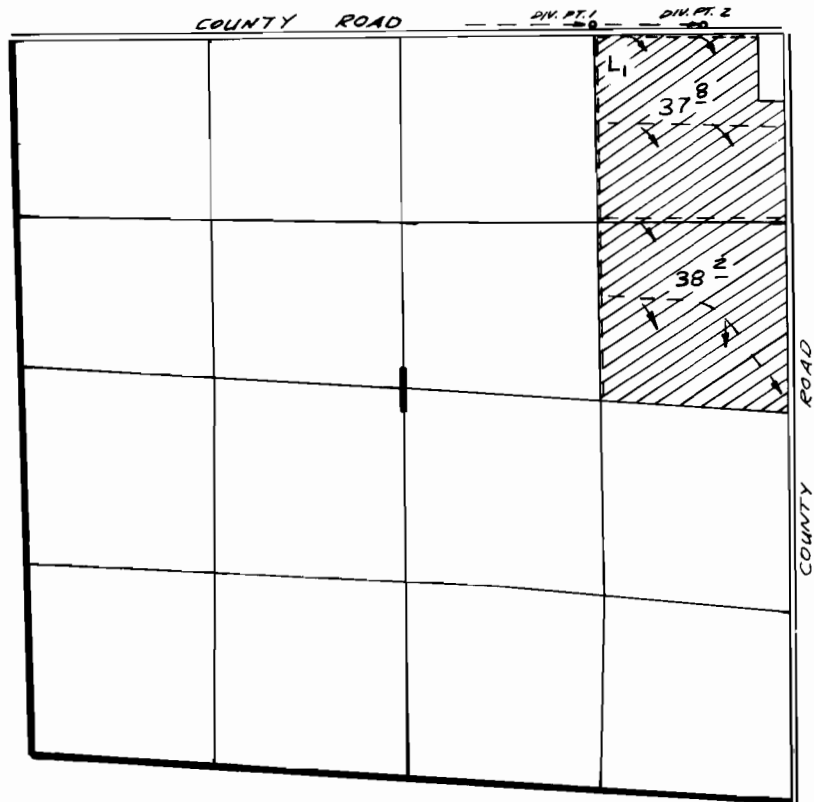

DIV. PT. 1 LOC 50' N & 1320' W FROM NE COR SEC 1
DIV. PT. 2 LOC 50' N & 560' W FROM NE COR SEC 1

FINAL PROOF SURVEY
UNDER

Application No. 52586 Permit No. 37772
IN NAME OF

LLOYD E. HUFF

Surveyed 5-30 1978, by R. BARWIN