


T. 7S. R. 45E. W.M.

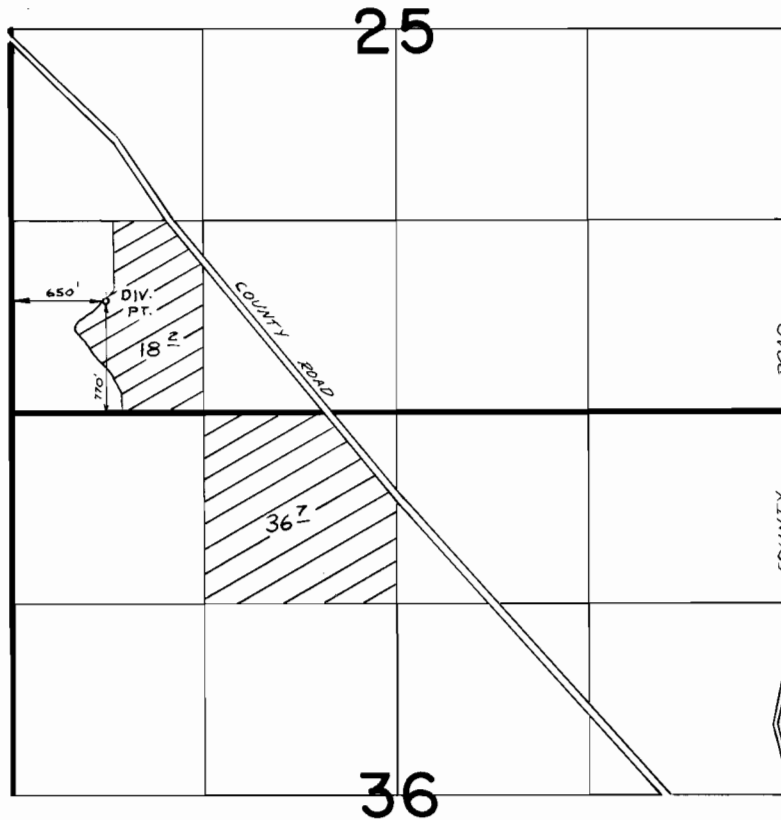

FINAL PROOF SURVEY
UNDER

Application No. 51801 Permit No. 39021
IN NAME OF

HENRY W. HARRIS

Surveyed 11-11 1978, by R. BARWIN