


T. 9S. R. 39E. W.M.

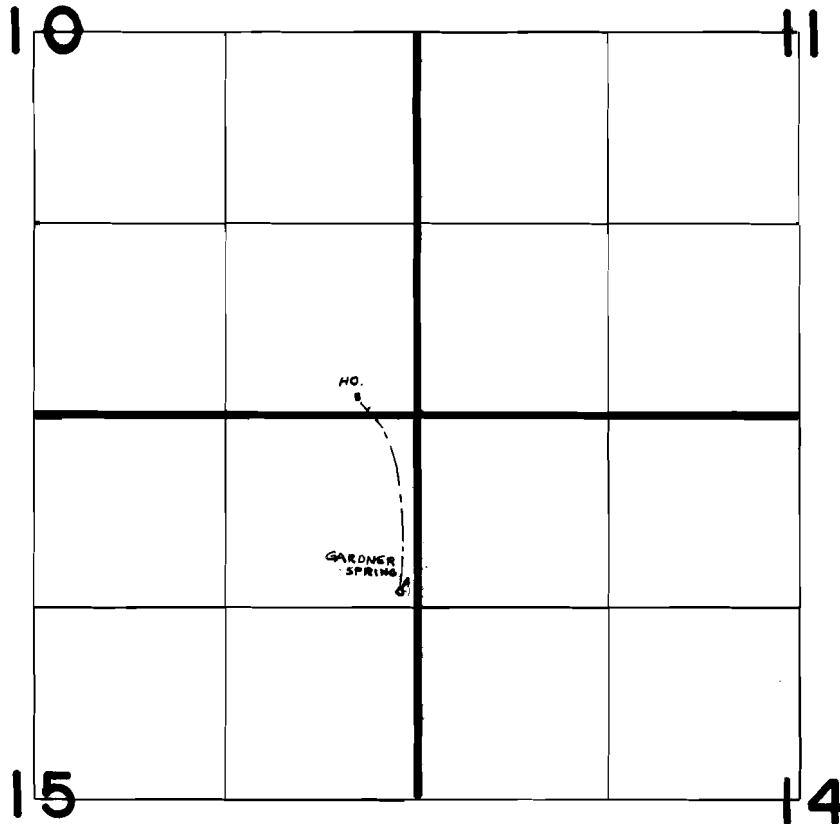

SPRING LOC. 1210'S & 110'W FROM NE COR. SEC 15

FINAL PROOF SURVEY
UNDER

Application No. **56523** Permit No. **42035**
IN NAME OF

GEORGE V. GARDNER

Surveyed **6-1** 1978, by **R. BARWIN**