


T. 8S., R. 45E., W.M.

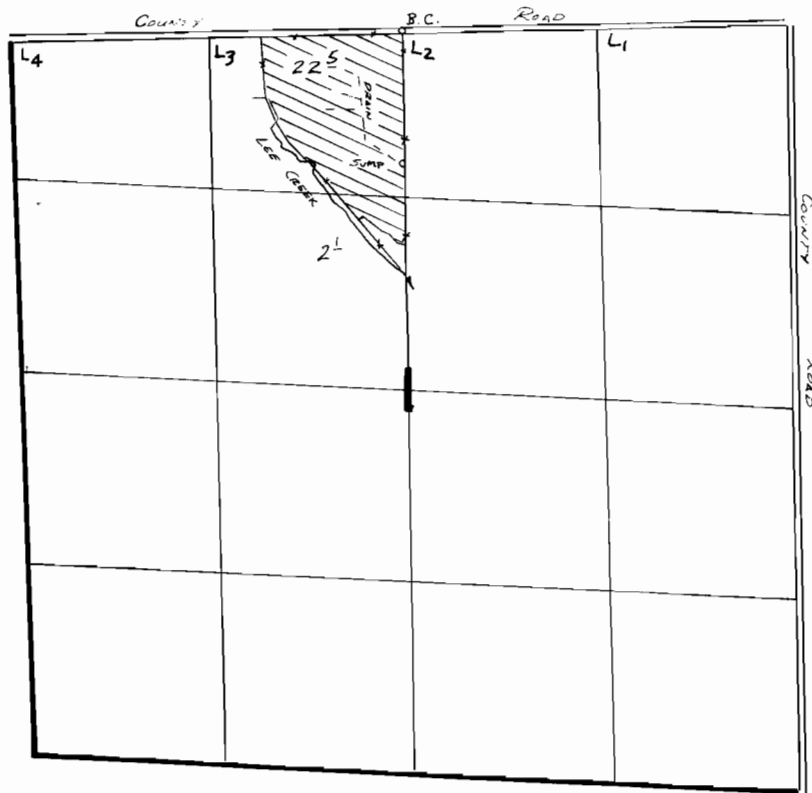

SUMP Loc: 920 S & 10 W. From N 1/4 COR. SEC. 1

**FINAL PROOF SURVEY**  
UNDER

Application No. **55608** Permit No. **42653**...  
IN NAME OF

.....**GEORGE M. LANGLEY**.....

Surveyed *May 31*..... 19*78*., by *R. BROWN*.....