


T.13S. R.6W. W.M.

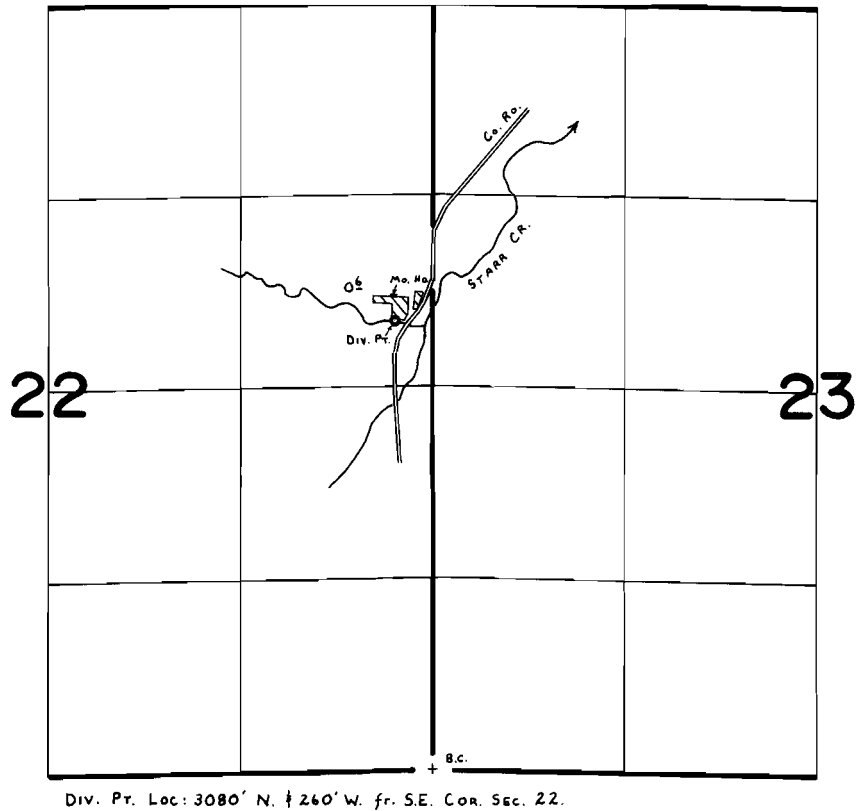

FINAL PROOF SURVEY
UNDER

Application No. 50526 Permit No. 37136.....
IN NAME OF

E. KAUFMAN.....

Surveyed May 29, 1980, by C. L. Hughes.....