


# T.5 S. R.1 E. W.M.

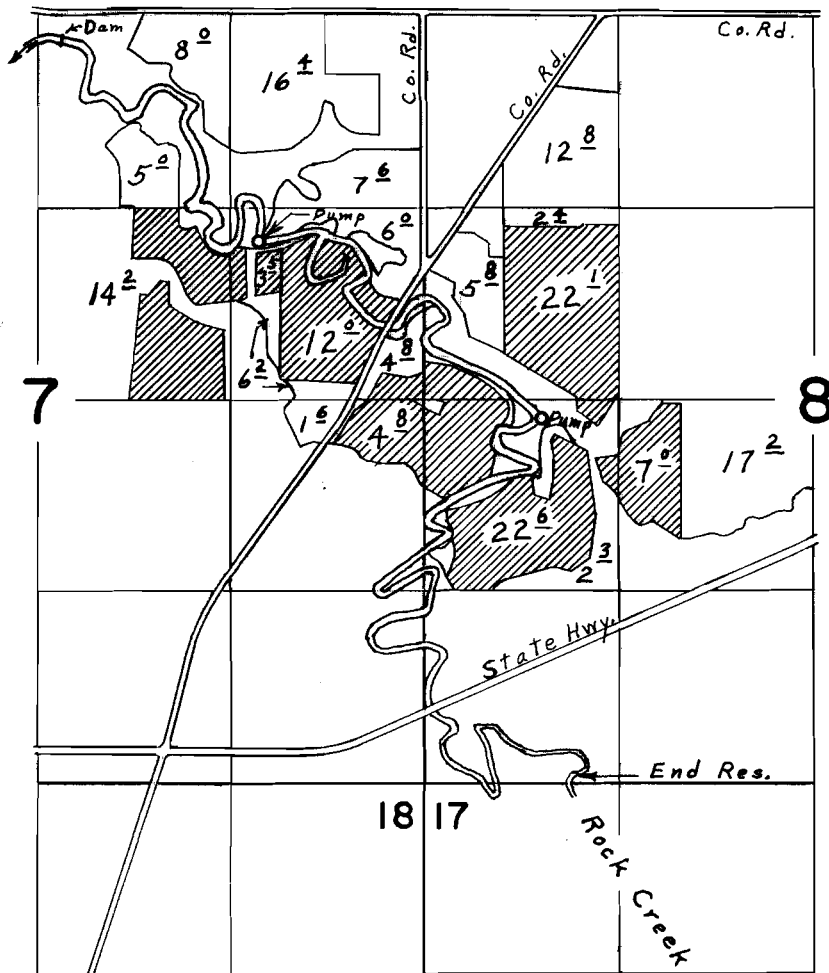

Div. Pt. located 180'S. & 2460' W. from N.E. Cor. Sec. 7

## FINAL PROOF SURVEY UNDER

R-44295                      R-5122  
 Application No. ~~44296~~ Permit No. ~~33083~~  
 IN NAME OF

**AAMODT DAIRY INC.**

Surveyed June 20, 1974, by L. E. Gould