


T4S. R3E. WM.

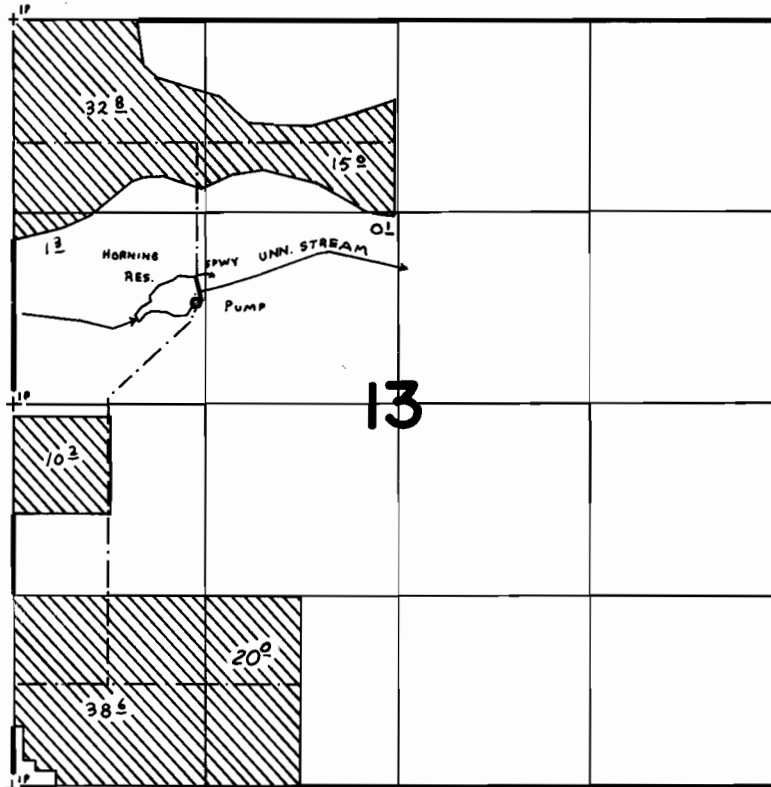

RES LOC: 1850'S. { 1260'E. }
PUMP LOC: 1940'S. { 1250'E. } BOTH fr. NW. COR. SEC. 13.

FINAL PROOF SURVEY UNDER

49214 35972
Application No. R-49213 Permit No. R-5819
IN NAME OF

U.S. DEPT. of the INTERIOR B.L.M.

Surveyed AUG. 3. 1978, by C. L. HUGHES.