


T. 26 & 27 S., R. 3 W., W.M.

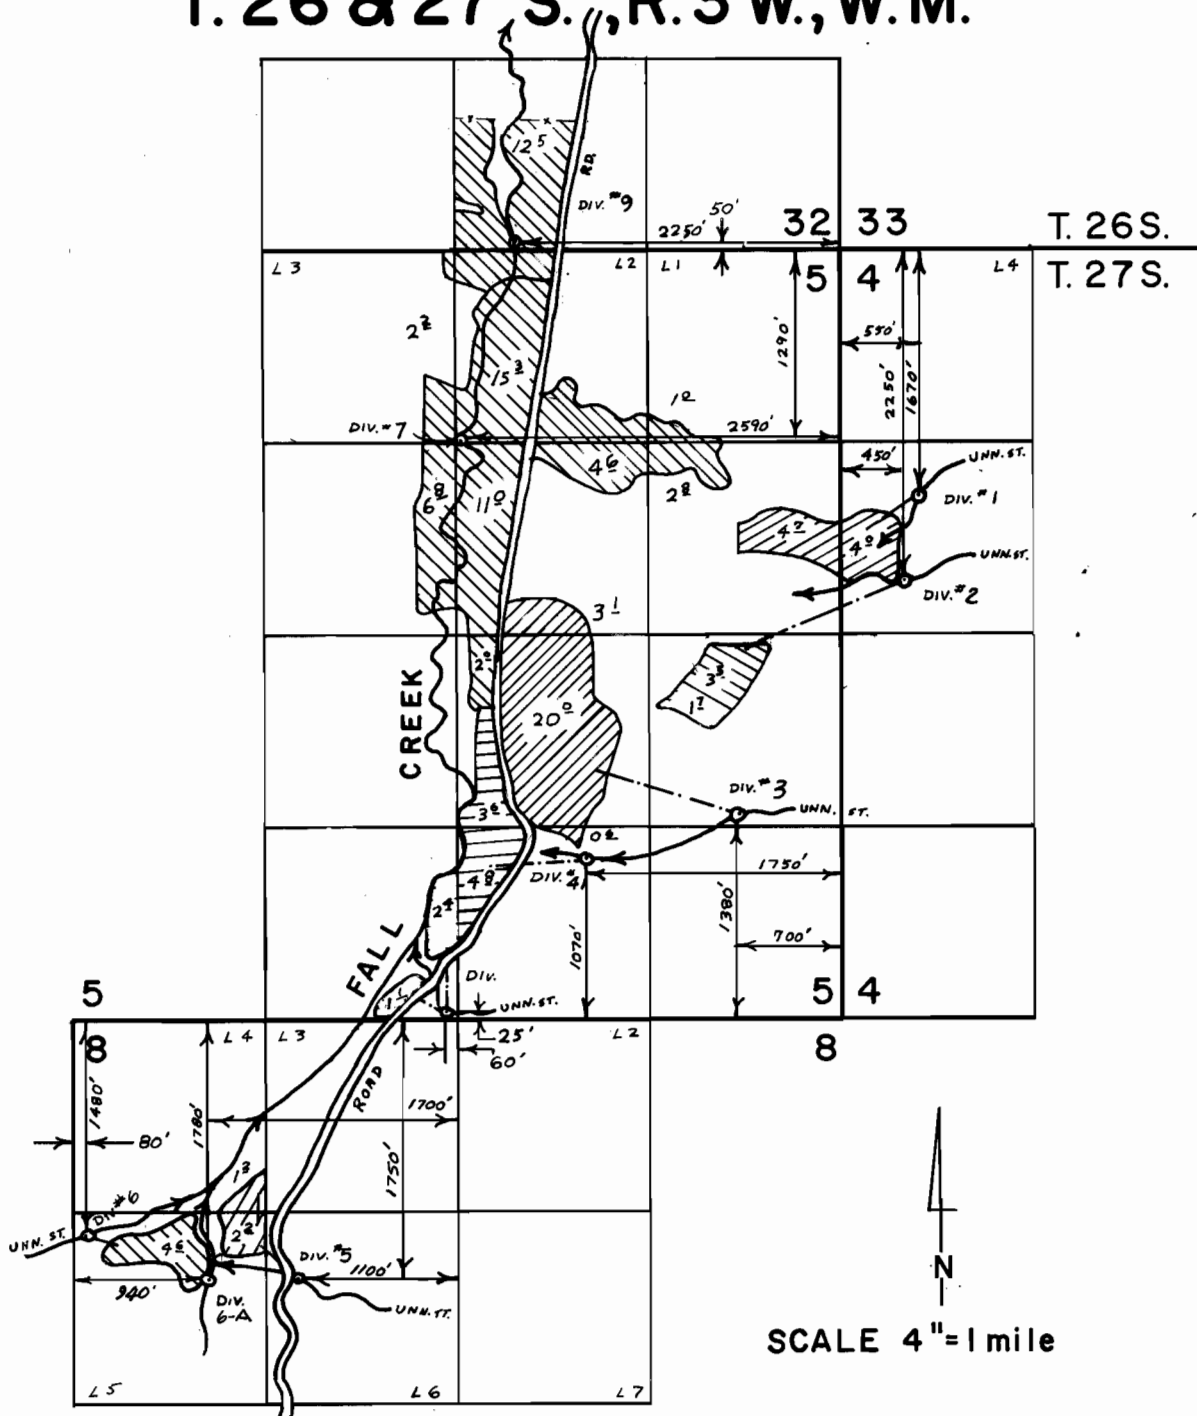

FINAL PROOF SURVEY UNDER

Application No. 43874. Permit No. 33006.
IN NAME OF

BEN SERAFIN

Surveyed Nov. 17, 1977, by D.W. Sparks...
JAN. 22, 1980 J. S. Donaldson