


T.30S. R.4W. W.M.

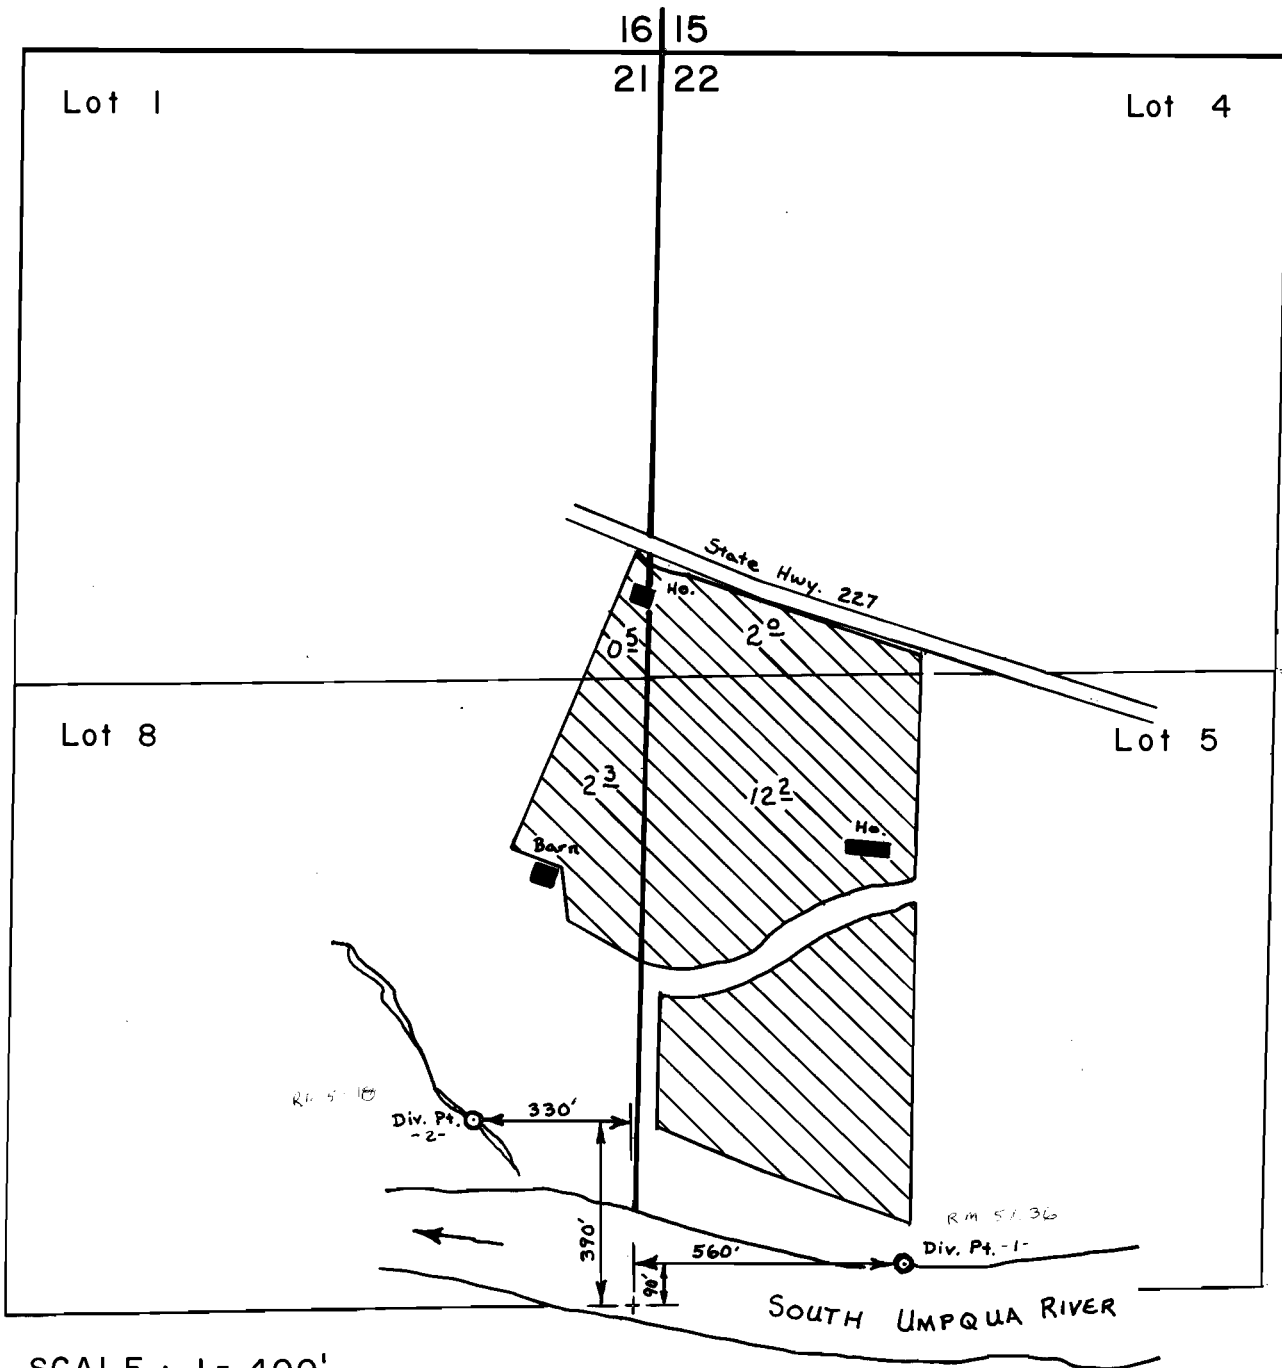

SCALE : 1 = 400'

FINAL PROOF SURVEY
UNDER

Application No. 50936 Permit No. 38457
IN NAME OF

ERVIN WHETZEL

Surveyed Feb. 3 1978, by D. Sparks