


T.26S.,R.2W.,W.M.

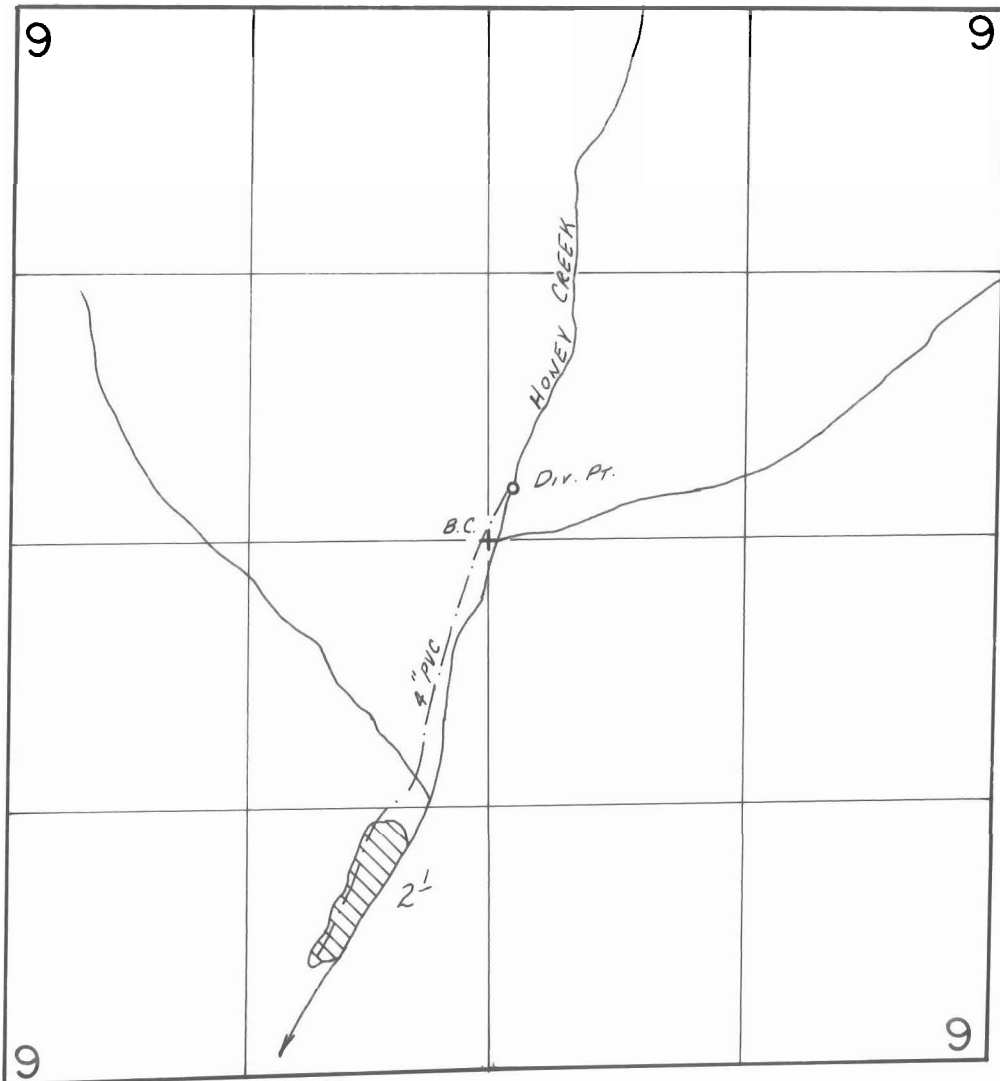

Div. Pt. Loc.: 250' N. & 120' E. FROM C. 1/4 COR. SEC. 9.

SCALE: 1" = 1000'

FINAL PROOF SURVEY
UNDER

Application No. 49514... Permit No. 37361.....
IN NAME OF

.....Michael Denman.....

Surveyed MAY 5..... 19.80., by J.S. DONALDSON