


T.27S. R.5W. W.M.

Sec. 23

SE 1/4 NW 1/4

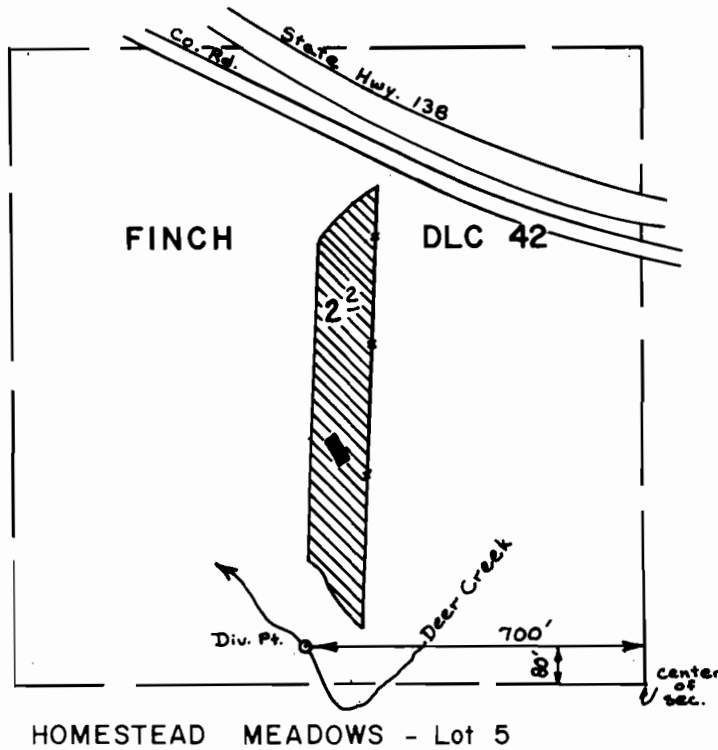

SCALE: 1" = 400'

FINAL PROOF SURVEY
UNDER

Application No. 50102 Permit No. 37646

IN NAME OF

FRANK MASSINGALE

Surveyed Aug. 2 1978, by D. Henry