


T.28S. R.6W. W.M.

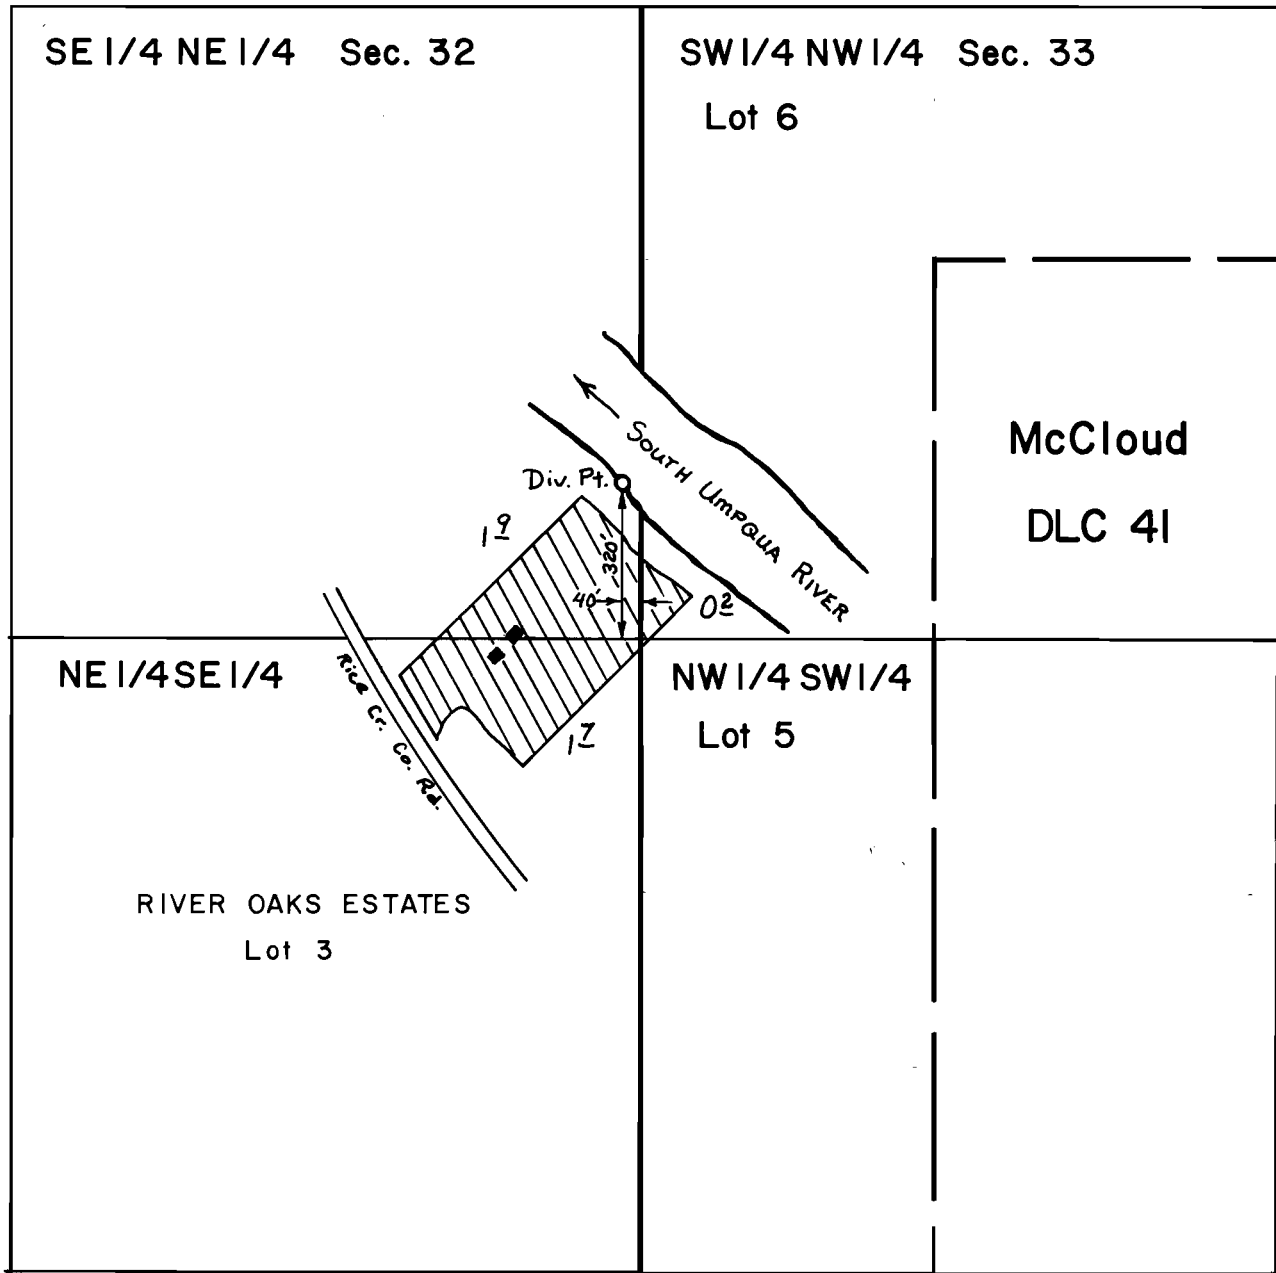

SCALE : 1" = 400'

FINAL PROOF SURVEY
UNDER

Application No. 51302 Permit No. 38737

IN NAME OF

JIM O. POLLARD

Surveyed June 23, 1978, by D. Sparks