


T.30S. R.2W. W.M.

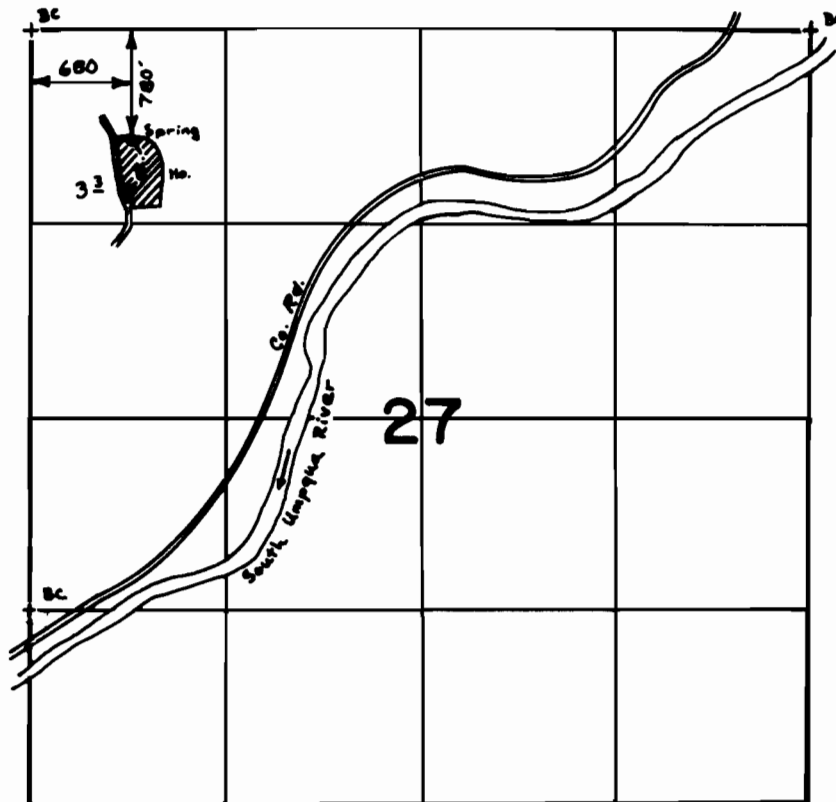

SCALE: 4" = 1 mile

FINAL PROOF SURVEY
UNDER

Application No. 51913 Permit No. 39161
IN NAME OF

Jim Ahola & Lisa Garden

Surveyed May 13, 1977, by D. Norby