


T.25S. R.5W. W.M.

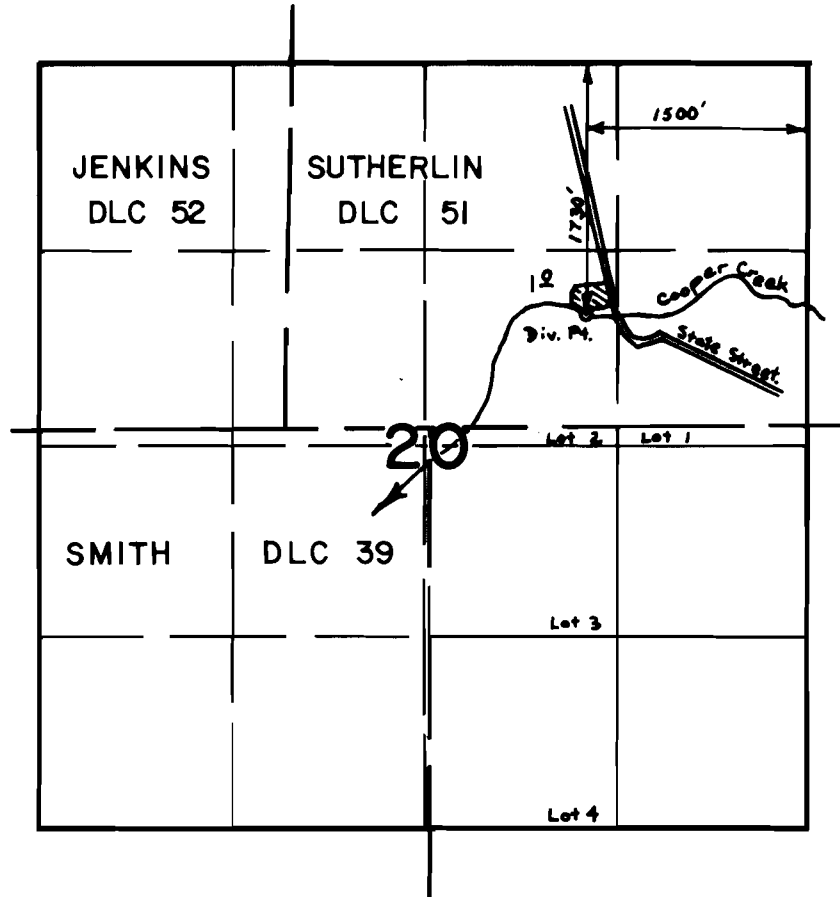

SCALE : 1" = 1320'

**FINAL PROOF SURVEY**  
UNDER

Application No. 53389 Permit No. 39739  
IN NAME OF

WALTER WILLIAMS

Surveyed Sept. 15, 1978, by D. Henry