


T.26S., R.3W., W.M.
SEC. 10

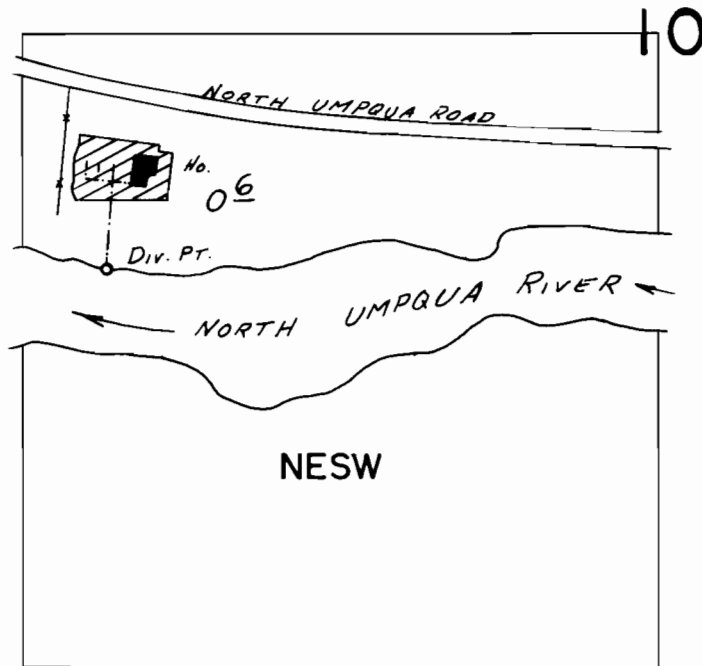

Div. Pt. Loc.: 490'S. & 1140'W. FROM CENTER SEC. 10.

SCALE: 1"=400'

FINAL PROOF SURVEY
UNDER

Application No. 55135... Permit No. 41396...
IN NAME OF

.....Robert S. & Janet L. Schafer.....

Surveyed JAN. 23. 1980., by J.S. DONALDSON

Sub