


T.26S., R.3W., W.M.
SEC. 34

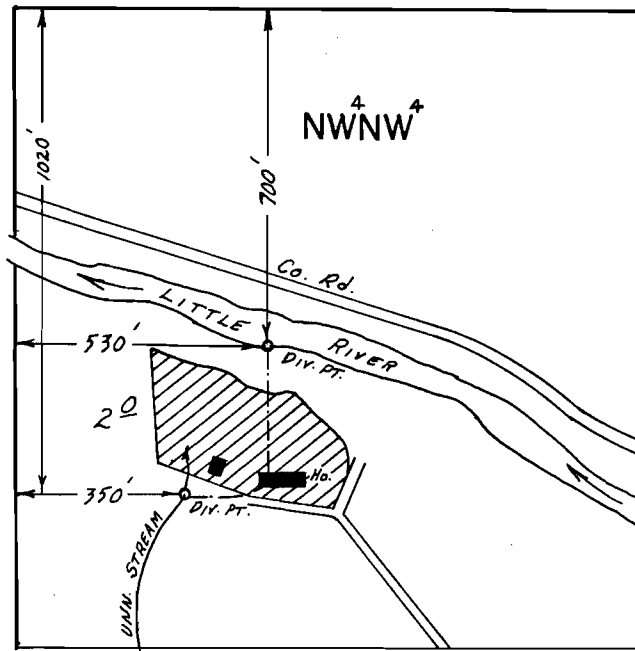

SCALE: 1" = 400'

FINAL PROOF SURVEY
UNDER

Application No. 56686 57003 Permit No. 42152 42903
IN NAME OF

.....ROBERT H. BOYLE.....

Surveyed JAN. 24... 1980., by J.S. DONALDSON