


T. 30 S. R. 5 W. W.M.

Application No. G-7630
Permit No. G 7186

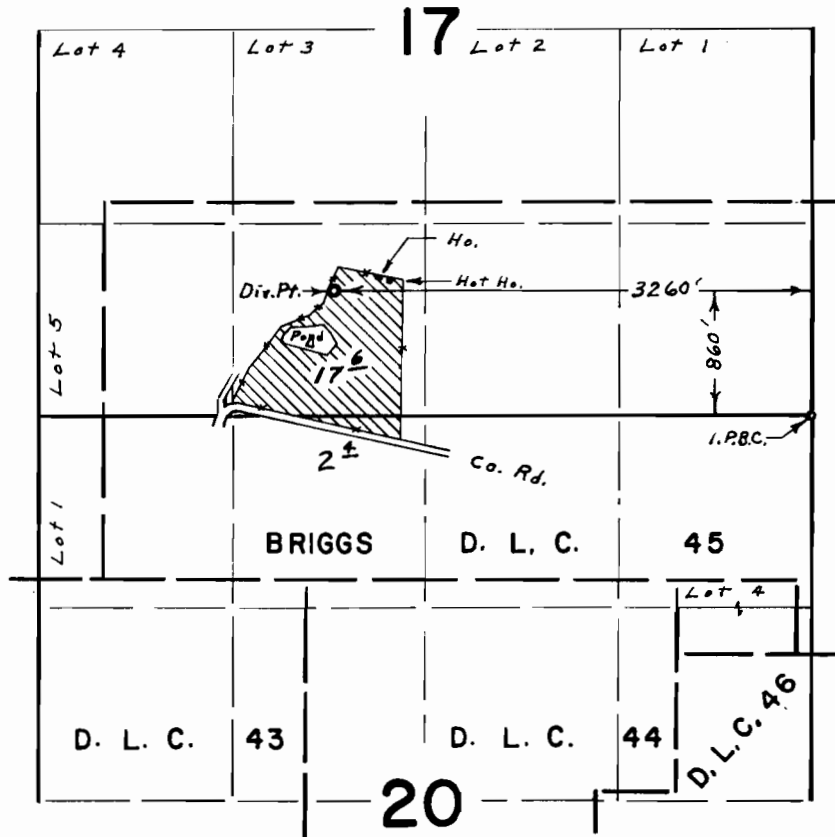

FINAL PROOF SURVEY
UNDER

Application No. G-3093. Permit No. G-2889.
IN NAME OF

RICHARD D. SCOTT

Surveyed Aug. 4, 1969, by L. E. Gould