


T19S. R25E. WM.

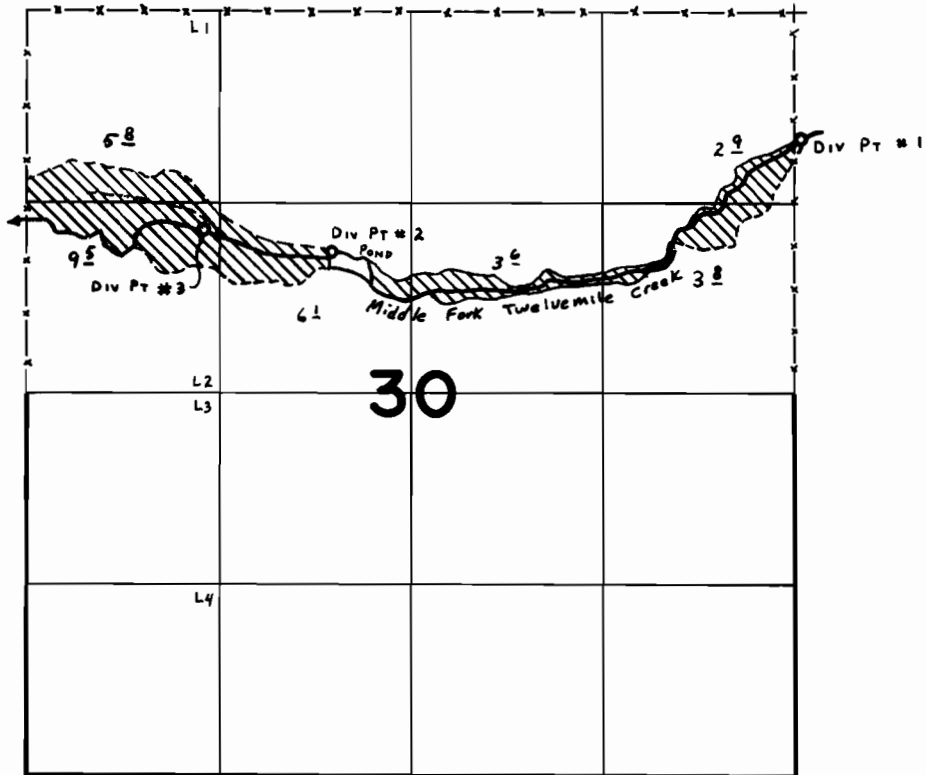

Div Pts Loc $\left\{ \begin{array}{l} \#1 - 870'S. \quad \{ 40'E. \\ \#2 - 1650'S. \quad \{ 3180'W. \\ \#3 - 1500'S. \quad \{ 4070'W. \end{array} \right\}$ ALL FROM NE COR. SEC. 30.

FINAL PROOF SURVEY UNDER

Application No. 43278 Permit No. 32346
IN NAME OF

CRISLEY BURGER

Surveyed AUG. 28 1978, by C. L. HUGHES