


# T.34 & 35 S., R.3 W., W.M.

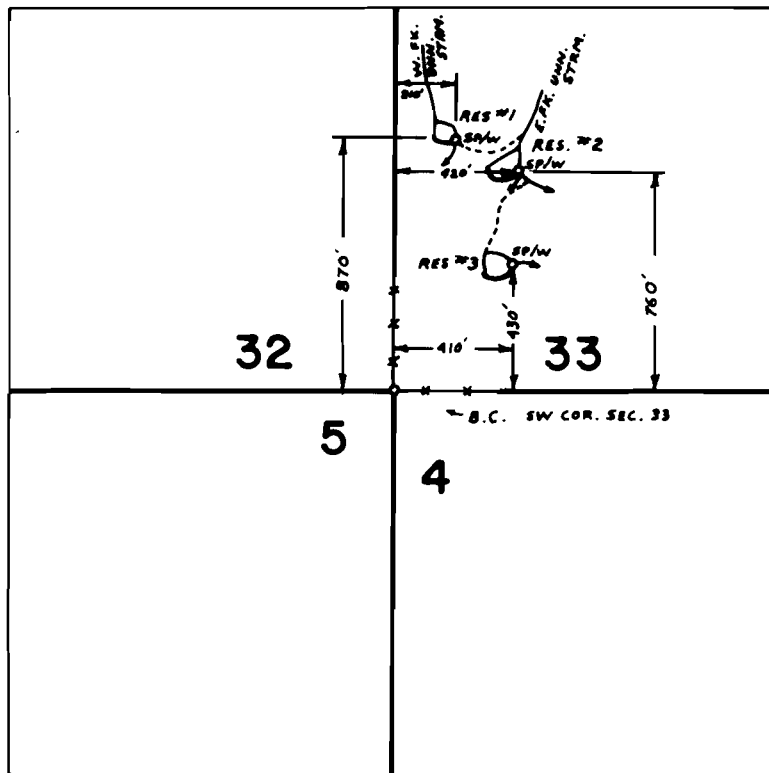

SCALE : 1" = 660 FT.

## FINAL PROOF SURVEY UNDER

Application No. R-54469 Permit No. R-6513  
IN NAME OF

DON A. FOWLER

Surveyed OCT. 6 1978, by B. SUND