


T. 34 S., R. 1 W., W.M.

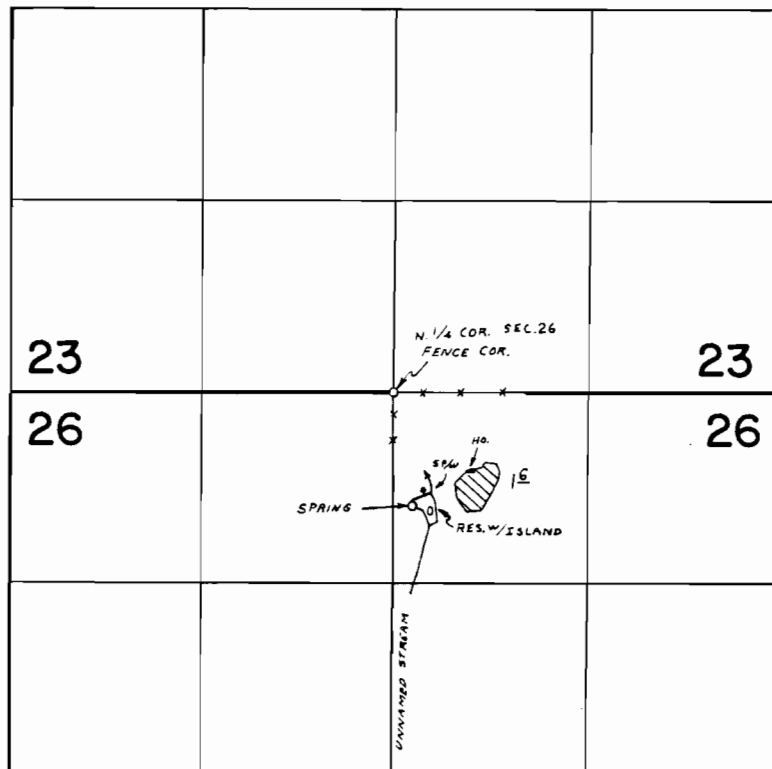

SPRING LOC. : 780' S. & 130' E. FROM N 1/4 COR. SEC. 26

DAM LOC. : 700' S. & 200' E. FROM N 1/4 COR. SEC. 26

FINAL PROOF SURVEY UNDER

R-48539 R-5895
48540 36431
Application No. Permit No.
IN NAME OF
HERBERT ZEMANSKY
Surveyed OCT. 24 1978 by B. SUND