


T.33 S., R.2 E., W.M.

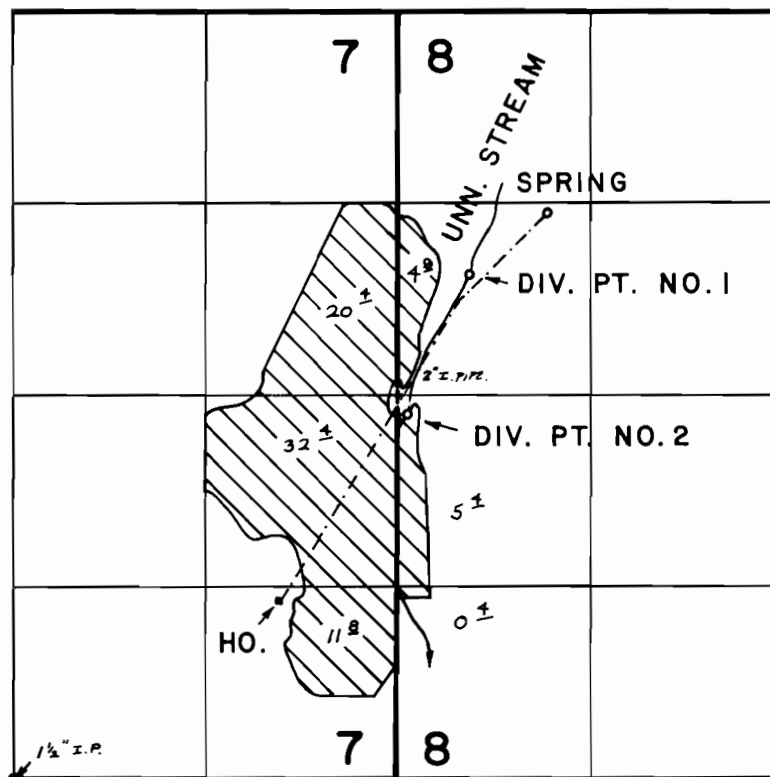

SPRING LOC. - 1250' N. & 1030' E., DIV. PT. #1 - 830' N. & 490' E.,
#2 - 130' S. & 70' E., ALL FROM W. 1/4 COR., SEC. 8.

**FINAL PROOF SURVEY
UNDER**

Application No. 43145 Permit No. 31868
IN NAME OF

JESSE W. EASTMAN

Surveyed AUG. 18 1978, by B. SUND